IREDELL COUNTY HEALTH DEPARTMENT

STATESVILLE 704-878-5305 MOORESVILLE 704-664-5281

IMPROVEMENT PERMIT / AUTHORIZATION TO CONSTRUCT / OPERATION PERMIT / EXISTING SYSTEM INSPECTION

PERMIT # 15665 19 PIN # 4761169724 DATE 5-13-09

OWNER or APPLICANT Dennis Jones PHONE: Business Home: 704-500-0318

OWNER or APPLICANT ADDRESS 138 Suffolk Ct Statesville NC 28677

LOCATION / DIRECTIONS 70 East - (R) Bethesda (R) Fieldcrest (L) on Sexton on left

SUBDIVISION Woodhaven Estates BLOCK / SECTION PH 1 LOT # 45 & 46 LOT AREA 1.53 DESIGN FLOW 360 L.T.A.R. 1051

Septic Tank EJ 1536 Gallons: STB EJ 1536 Date 4/15/09

Pump Tank ____ Gallons: P T ____ Date ____

Pump Make ____ Model ____ Serial # ____

Nitrification Field No Fields ____ No Lines ____ Linear Feet 300

Trench Width 36" Max. Trench Bottom Depth 36" Gravel Depth 12"

☐ New System ☐ Repair ☐ Expansion System Type I (II) III IV V VI

System Description: Existing

Repair System Description: 25% Expansion

Maintenance Agreement Required ☐ YES ☐ NO

☑ GRAVITY ☐ PRESSURE

☑ Residence No. Bedrooms 3

☐ Business No. Persons ____

☐ Other No. Employees ____

☐ Slab ☑ Crawl Space

☐ Basement w/plumbing ☐ Basement w/o plumbing


Water Supply: ☑ Private ☐ Public ☐ Community

Comments / Conditions


Need to pump existing tank prior to hook up

Comments / Conditions

INITIAL SITE SKETCH

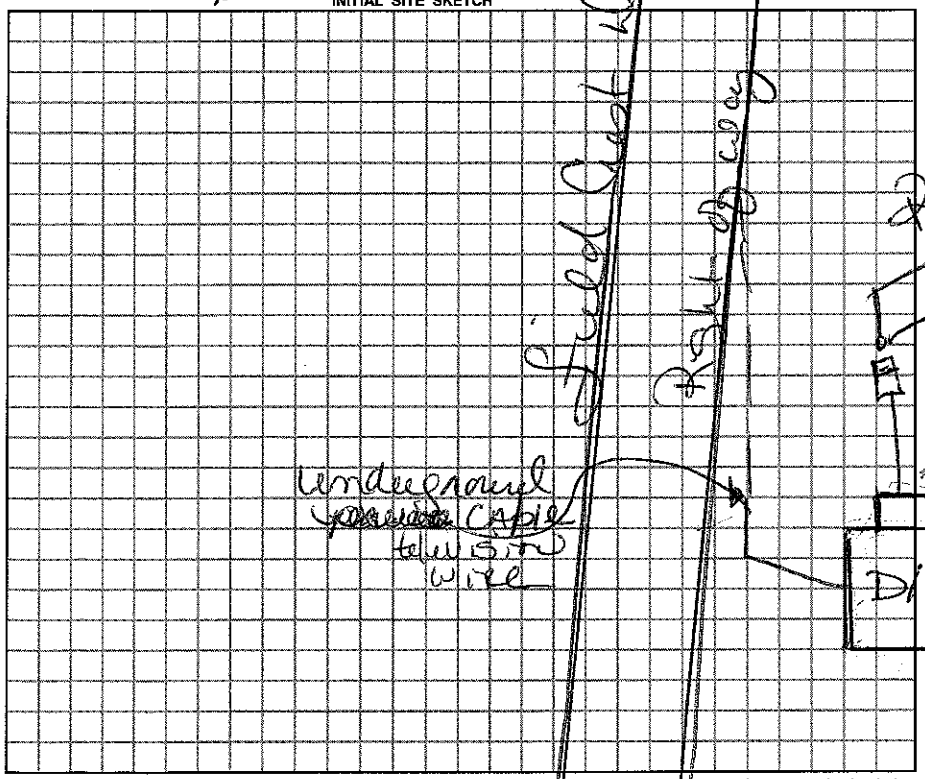

AS BUILT SKETCH

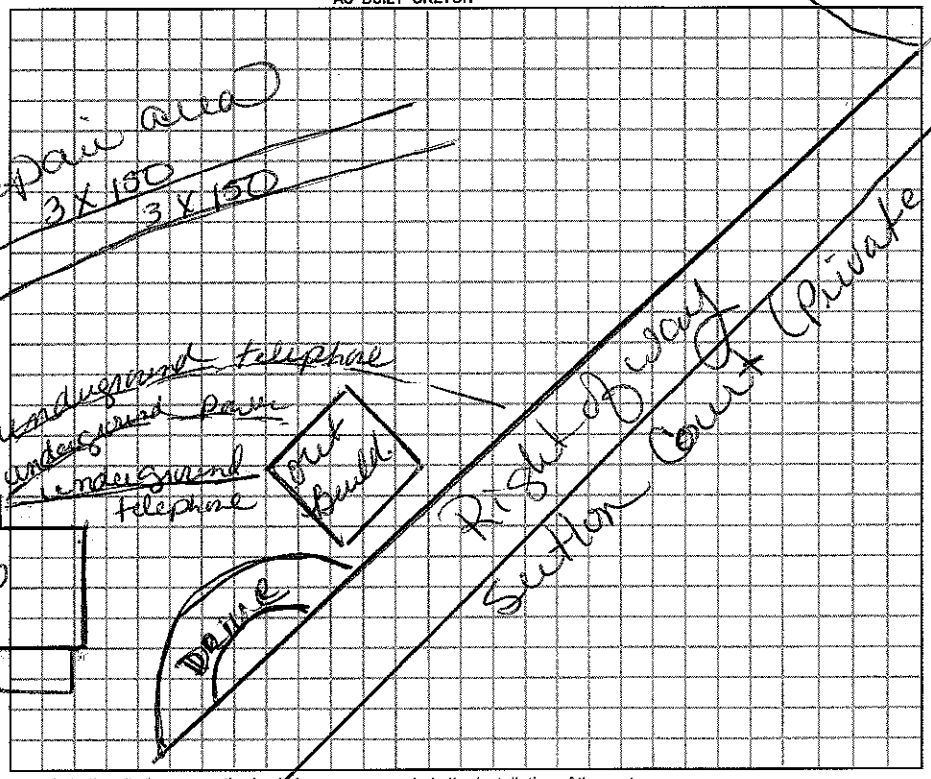

Permit can be suspended or revoked if any false information is supplied toward securing the permit / any unauthorized changes are made to the site / any unauthorized changes are made in the installation of the system.

☐ *IMPROVEMENT PERMIT w / plat valid without expiration.* ☐ *IMPROVEMENT PERMIT w / site plan valid for 60 mos.* ☑ *AUTHORIZATION TO CONSTRUCT valid for period equal to IMPROVEMENT PERMIT-not to exceed 60 mo.*

Owner / Applicant Signature: X Dennis Jones Date ____

Improvement Permit by: ____ Date ____

Authorization to Construct by: ____ Date ____

Installed by: ____

Operation Permit by: ____ Date: ____

Existing System Inspected by: Kelly Cook Date: 5-13-09

YOU SHOULD CONTACT A LOCATOR SERVICE PRIOR TO ANY EXCAVATION

WHITE COPY Environmental Health YELLOW COPY (Final) Owner / Applicant PINK COPY (Initial) Owner / Applicant