IREDELL COUNTY HEALTH DEPARTMENT

STATESVILLE 704-878-5305 MOORESVILLE 704-664-5281

IMPROVEMENT PERMIT / AUTHORIZATION TO CONSTRUCT / OPERATION PERMIT / EXISTING SYSTEM INSPECTION

PERMIT# 24065 PIN# Tax map 5B-3-A-36 DATE 3-19-98

OWNER OR CONTRACTOR Wayne Hays PHONE: Business Home 663-2220

ADDRESS Rt 2 Box 196 E (204 Jeremy Lane)

LOCATION Hwy 70 E TR ~~triplet~~ Bethania TR Ruben TL Jeremy Next to last rt

SUBDIVISION Beechwood BLOCK / SECTION II LOT 36 LOT AREA 100'X224' SITE CLASS. P5 DESIGN FLOW 360 L.T.A.R. 1.33

Septic Tank: 1000 Gallons; STB ____ Date 3-27-98

Pump Tank: ____ Gallons; PT ____ Date ____

Pump Make: ____ Model ____ Serial No. ____

Nitrification Field: No Fields 1 Square Feet 1080 Linear Feet 360

No Lines 5 Trench Width 36" Max Trench Bottom Depth 36" Gravel Depth 12"

☑ New System ☐ Repair System Type: I, II, III, IV, V, VI

System Description: Conv. Gravity

Repair System Description: Gravity Chambers

Maintenance Agreement Required: ☐ Yes ☑ No

☐ House/Mod. Home ☑ Mobile Home ☐ Business ☐ Other

No. Bedrooms 3 No. Bathrooms 2 No. Employees ____


☐ Slab ☑ Crawl Space ☐ Basement w/plumbing ☐ Basement wo/plumbing

Water Supply: ☑ Individual ☐ Public ☐ Community


Comments:/Conditions:

Comments:/Conditions:

INITIAL SITE SKETCH

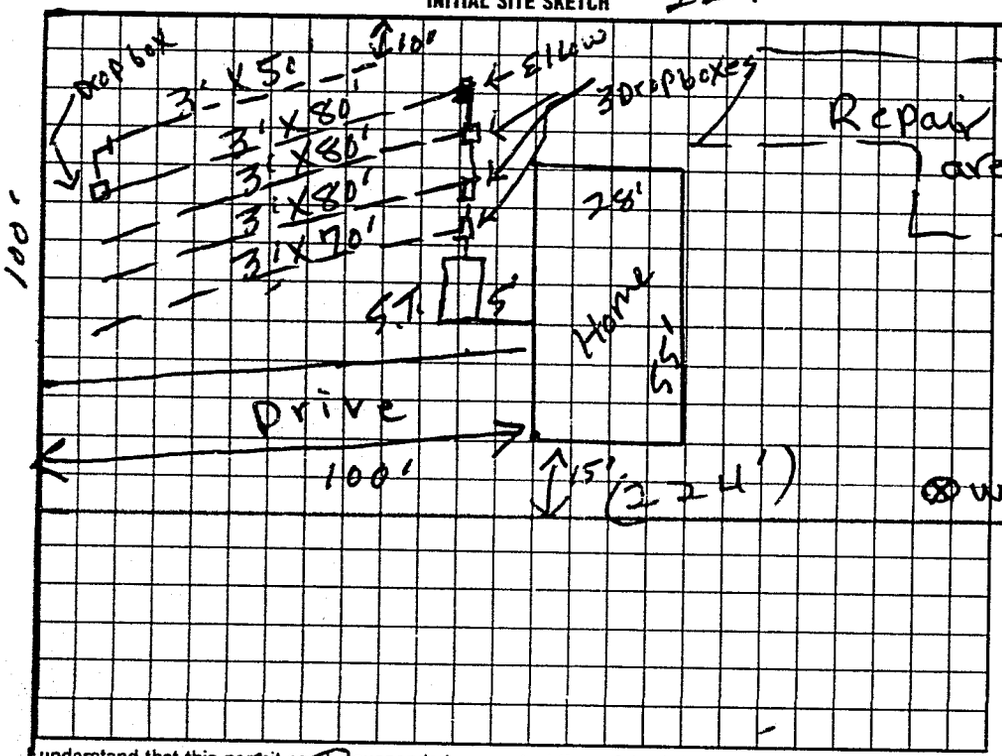

AS BUILT SKETCH

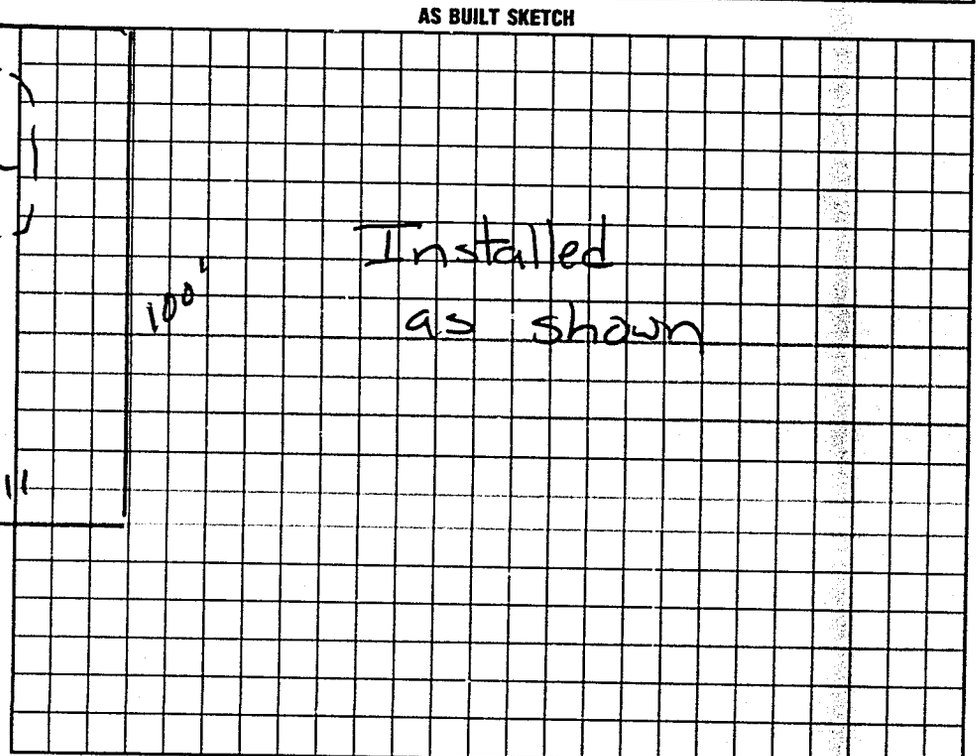

I understand that this permit can be suspended or revoked if any false information is supplied toward securing the permit/any unauthorized changes are made to the site/any unauthorized changes are made in the installation of the system. Improvement Permit with plat valid without expiration. Improvement Permit with site plan valid for sixty months. Authorization to Construct is valid for a period equal to that of Improvement Permit – not to exceed sixty months.

Signed: ____ date ____ Installed by: A-1 Backhoe

Improvement Permit by: L. C. Moore date 3-19-98 Operation Permit by: Mark C Outlaw date 4-21-98

Authorization to Construct by: L. C. Moore date 3-19-98 Existing System Inspection by: ____ date ____

HEALTH DEPT. COPY (WHITE) INSPECTION COPY (FINAL): GREEN OWNER COPY (FINAL): YELLOW INSPECTION COPY (INITIAL): PINK OWNER COPY (INITIAL): GOLD