IREDELL COUNTY HEALTH DEPARTMENT

STATESVILLE 704-878-5305 MOORESVILLE 704-664-5281

IMPROVEMENT PERMIT / AUTHORIZATION TO CONSTRUCT / OPERATION PERMIT / EXISTING SYSTEM INSPECTION

PERMIT# 79604 PIN# 4761194088 DATE 3-8-99

OWNER OR CONTRACTOR Jonathan Lestir PHONE: Business Home 954 476 9720

ADDRESS 12850 State Rd 84 Ft Lauderdale

LOCATION 702 TR Bethesda TR Reuben at end

SUBDIVISION Beechwood BLOCK / SECTION LOT 62 LOT AREA 1 acre SITE CLASS PS DESIGN FLOW 360 L.T.A.R. .28

Septic Tank: 1000 Gallons; STB 312 Date 10-17-99
Pump Tank: Gallons; PT Date
Pump Make: Model Serial No.
Nitrification Field: No Fields 1 Square Feet 428 Linear Feet 214
No Lines 2 Trench Width 24" Max Trench Bottom Depth 36" Gravel Depth N/A

☑ New System ☐ Repair System Type: I, II, III, IV, V, VI
System Description: Gravity Porus Block Panel
Repair System Description:
Maintenance Agreement Required: ☐ Yes ☑ No


☑ House/Mod. Home No. Bedrooms 3
☐ Mobile Home No. Bathrooms 2
☐ Business No. Employees
☐ Other
☐ Slab ☑ Crawl Space ☐ Basement w/plumbing ☐ Basement wo/plumbing

Water Supply: ☑ Individual ☐ Public ☐ Community

Comments/Conditions:

123'

INITIAL SITE SKETCH

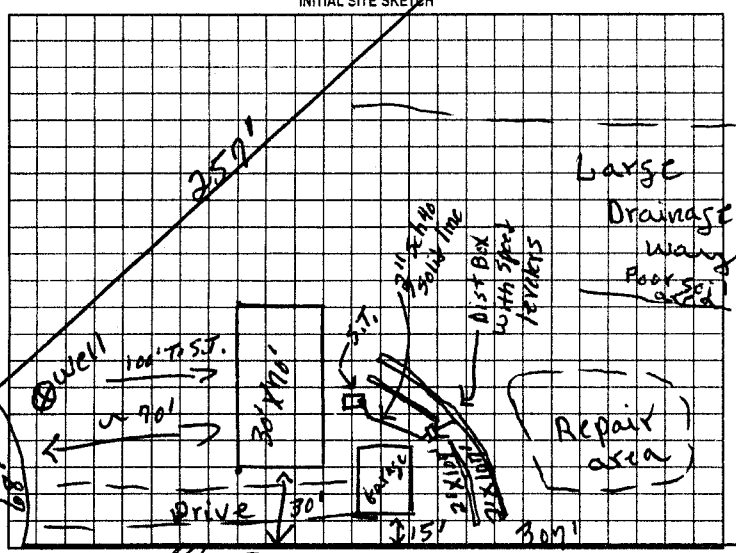


Comments/Conditions:

well Not on site at Time of this inspection

AS BUILT SKETCH

Keep location as shown

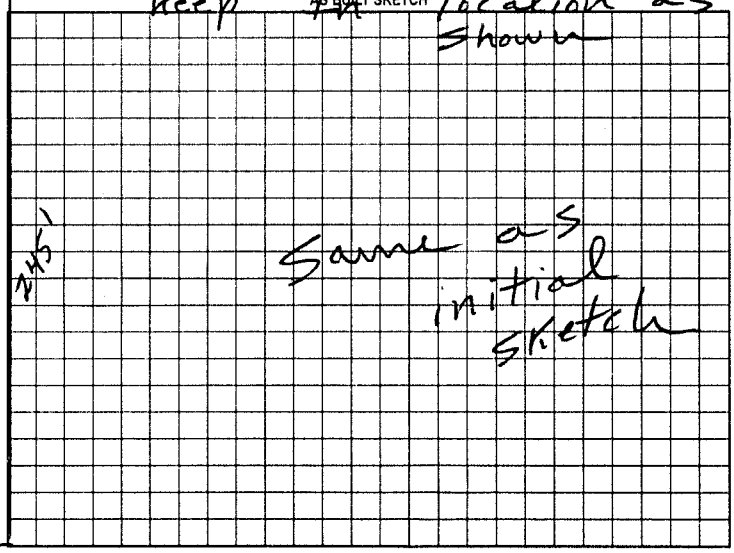

Permit can be suspended or revoked if any false information is supplied toward securing the permit/any unauthorized changes are made to the site/any unauthorized changes are made in the installation of the system. Improvement Permit with plat valid without expiration. Improvement Permit with site plan valid for sixty months. Authorization to Construct is valid for a period equal to that of Improvement Permit – not to exceed sixty months.

Signed: date 3-17-99 Installed by: Kenny Matison

Improvement Permit by: P.C. moore date 3-8-99 Operation Permit by: P.C. moore date 11-23-99

Authorization to Construct by: P.C. moore date 3-8-99 Existing System Inspection by: date

HEALTH DEPT. COPY WHITE OWNER COPY (FINAL) YELLOW OWNER COPY (INITIAL) PINK