Kesinburg ox Coop

IREDELL COUNTY HEALTH DEPARTMENT

STATESVILLE 704-878-5305 MOORESVILLE 704-664-5281

54065 3100

IMPROVEMENT PERMIT / CERTIFICATE OF COMPLETION / OPERATION PERMIT / EXISTING SYSTEM INSPECTION

PROPERTY DESCRIPTION NO. 19619 DATE 12-13-94 TAX MAP NO. 56-3-A-63 Watershed: ☐ Yes ☒ No

OWNER OR CONTRACTOR Keith Hembree PHONE: Business _____ Home ~~704-~~ 785-7033

ADDRESS 7051 B Cameron Ave NE Concord

LOCATION 703 TR Bethania TR Reuben Pl. at end of cul-de-sac

SUBDIVISION Beechwood BLOCK / SECTION A LOT 63 LOT AREA .99 acres SITE CLASS. P5 DESIGN FLOW 360 L.T.A.R. .35

Septic Tank: 1000 Gallons; STB 794 Date 11-7-94 ☒ New System ☐ Repair System Type: I, II, III, IV, V, VI

Pump Tank: _____ Gallons; PT _____ Date _____ System Description: Conv. Gravity

Pump Make: _____ Model _____ Serial No. _____ Repair System Description: Gravity Pipe & Block

Nitrification Field: No Fields 1 Square Feet 1050 Linear Feet 350 Maintenance Agreement Required: ☐ Yes ☒ No Pine

No Lines 4 Trench Width 34" Max Trench Bottom Depth 36" Gravel Depth 12" ☐ Slab ☒ Crawl Space ☐ Basement w/plumbing ☐ Basement wo/plumbing


☐ House/Mod. Home No. Bedrooms 3
☒ Mobile Home No. Bathrooms 2
☐ Business No. Employees ____
☐ Other ____

Water Supply: ☒ Individual ☐ Community ☐ Public


Comments:

Comments: well was not on site at Time of this inspection Keep proper Distance from S.T. System

INITIAL SITE SKETCH

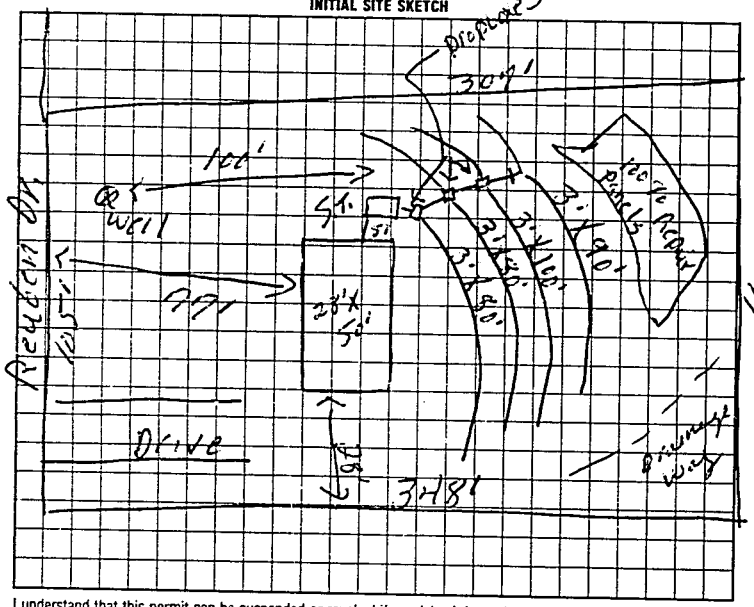

AS BUILT SKETCH

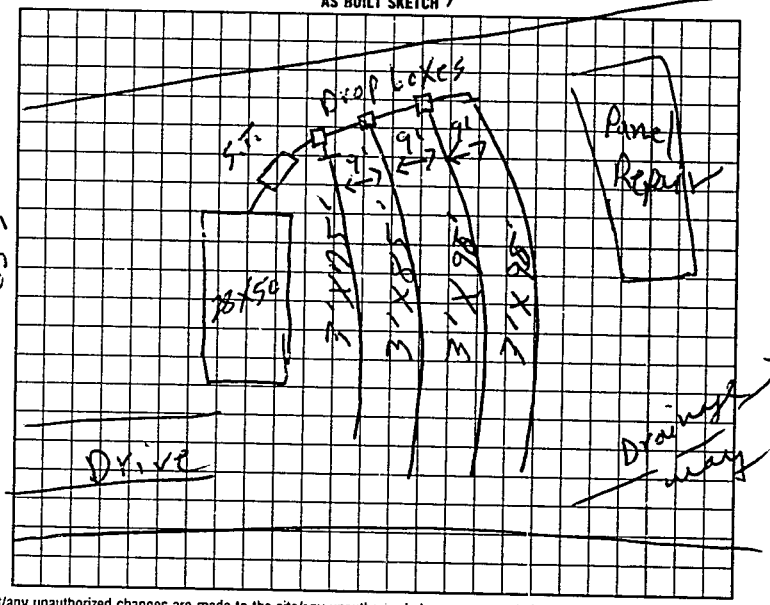

I understand that this permit can be suspended or revoked if any false information is supplied toward securing the permit/any unauthorized changes are made to the site/any unauthorized changes are made in the installation of the system. Improvement Permit is valid for 60 months from date of issuance.

Signed: X Keith Hembree

Improvement Permit by: F. C. Moore date 12-13-94

Existing System Inspection by: _____ date _____

Installed by: Barry Tucker

Certificate of Completion by: F. C. Moore date 1-3-95

Operation Permit by: _____ date _____

HEALTH DEPT. COPY: WHITE INSPECTION COPY (FINAL) GREEN OWNER COPY (FINAL): YELLOW INSPECTION COPY (INITIAL): PINK OWNER COPY (INITIAL): GOLD