IREDELL COUNTY HEALTH DEPARTMENT

STATESVILLE 704-878-5305 MOORESVILLE 704-664-5281

IMPROVEMENT PERMIT / AUTHORIZATION TO CONSTRUCT / OPERATION PERMIT / EXISTING SYSTEM INSPECTION

PERMIT # 153633 PIN # 4761196576 DATE Dec. 5, 2008

OWNER or APPLICANT Randy Shultz PHONE: Business 803-308-4190 Home:

OWNER or APPLICANT ADDRESS 1940 Reuben Dr. Statesville 28677

LOCATION / DIRECTIONS Bethesda Rd Reuben / 194 Reuben Drive

SUBDIVISION Beechwood BLOCK / SECTION 1 & 2 LOT # 65 LOT AREA DESIGN FLOW 240 L.T.A.R. Exist

Septic Tank Exist Gallons: STB Exist Date Exist

Pump Tank Gallons: P T Date

Pump Make Model Serial #

Nitrification Field No Fields No Lines 4 Linear Feet 240

Trench Width 36" Max. Trench Bottom Depth 36" Gravel Depth 12

☐ New System ☐ Repair ☐ Expansion System Type I II III IV V VI

System Description: Gravity Conventional

Repair System Description: Soil Absorb

Maintenance Agreement Required ☐ YES ☒ NO

☐ GRAVITY ☐ PRESSURE

☒ Residence No. Bedrooms 2

☐ Business No. Persons

☐ Other No. Employees

☐ Slab ☐ Crawl Space

☐ Basement w/plumbing ☐ Basement w/o plumbing


Water Supply: ☒ Private ☐ Public ☐ Community

Comments / Conditions

Comments / Conditions

INITIAL SITE SKETCH

AS BUILT SKETCH

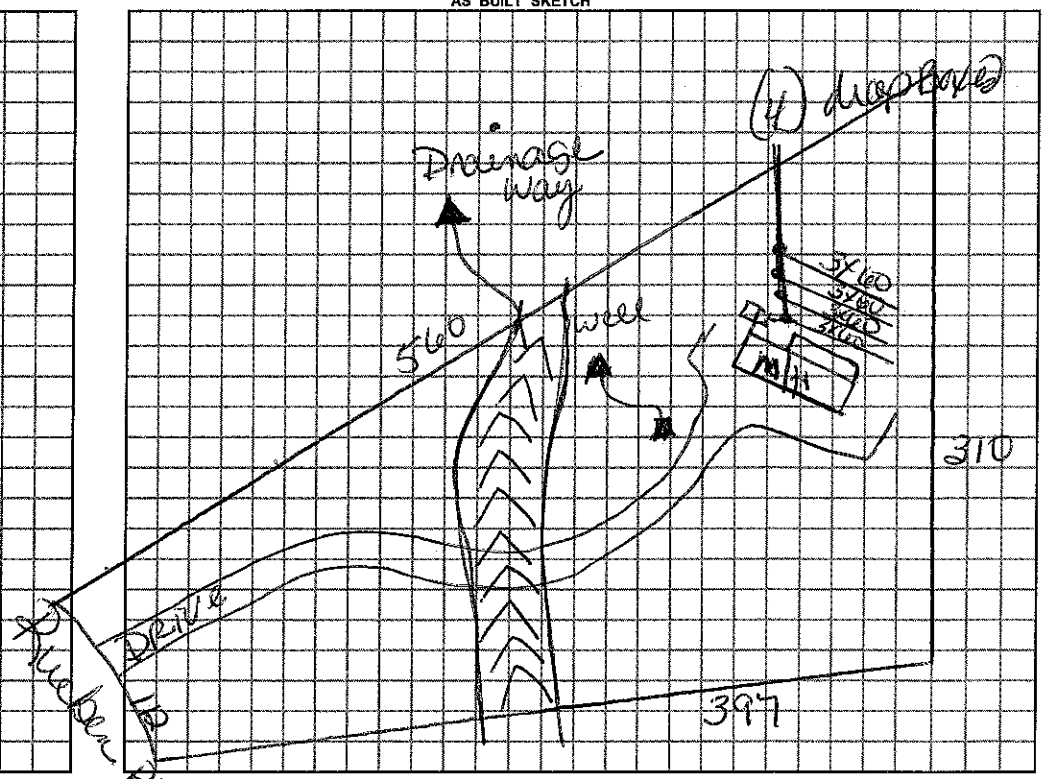

Permit can be suspended or revoked if any false information is supplied toward securing the permit / any unauthorized changes are made to the site / any unauthorized changes are made in the installation of the system.

☐ *IMPROVEMENT PERMIT w / plat valid without expiration.* ☐ *IMPROVEMENT PERMIT w / site plan valid for 60 mos.* ☒ *AUTHORIZATION TO CONSTRUCT valid for period equal to IMPROVEMENT PERMIT-not to exceed 60 mo.*

Owner / Applicant Signature: Randy Shultz Date

Improvement Permit by: Date

Authorization to Construct by: Date

YOU SHOULD CONTACT A LOCATOR SERVICE PRIOR TO ANY EXCAVATION.

Installed by:

Operation Permit by: Date:

Existing System Inspected by: Date: 12-5-08

WHITE COPY Environmental Health YELLOW COPY (Final) Owner / Applicant PINK COPY (Initial) Owner / Applicant