10:30

IREDELL COUNTY HEALTH DEPARTMENT

STATESVILLE 704-878-5305 MOORESVILLE 704-664-5281

IMPROVEMENT PERMIT / AUTHORIZATION TO CONSTRUCT / OPERATION PERMIT / EXISTING SYSTEM INSPECTION

PERMIT# 77709 PIN# 4761985666 DATE 11-19-98

OWNER OR CONTRACTOR Glenn Westbrook PHONE: Business Home 528 0852

ADDRESS 194 Ruben Dr. Statesville, NC.

LOCATION 70 E 4R Bethesta TR Ruben 1/4mi on Rt

SUBDIVISION Beachwood BLOCK / SECTION LOT 66 LOT AREA 1.42acres SITE CLASS PS DESIGN FLOW 240 L.T.A.R. .32

Septic Tank: 1000 Gallons; STB 794 Date 11/10/98
Pump Tank: Gallons; PT Date
Pump Make: Model 750 Serial No. 250
Nitrification Field: No Fields 1 Square Feet ~~250~~ Linear Feet ~~750~~
No Lines 5 Trench Width 36" Max Trench Bottom Depth 36" Gravel Depth 12"

☑ New System ☐ Repair System Type: I, II, III, IV, V, VI
System Description: Conv. Gravity
Repair System Description: Pump To Conv.
Maintenance Agreement Required: ☐ Yes ☑ No

☐ House/Mod. Home No. Bedrooms 3
☑ Mobile Home No. Bathrooms 2
☐ Business No. Employees
☐ Other


☐ Slab ☑ Crawl Space ☐ Basement w/plumbing ☐ Basement wo/plumbing

Water Supply: ☑ Individual ☐ Public ☐ Community


Comments:/Conditions:
400'

Comments:/Conditions:
well Not on site at Time of inpection

INITIAL SITE SKETCH

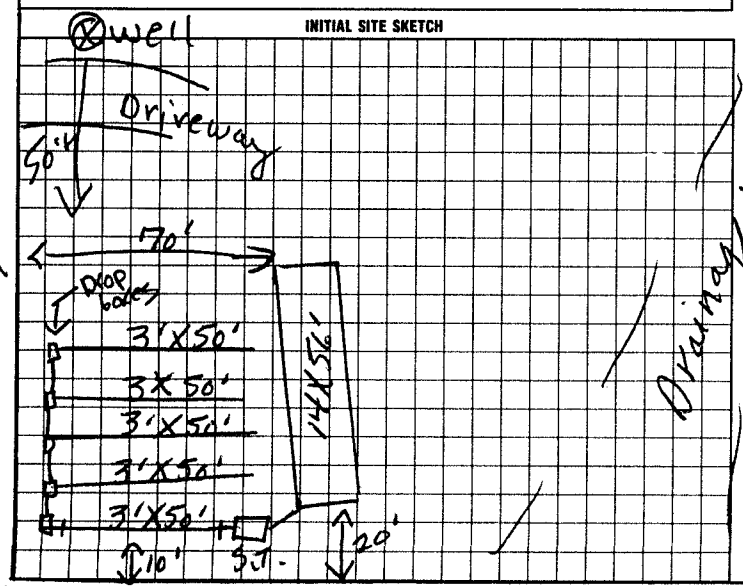

AS BUILT SKETCH

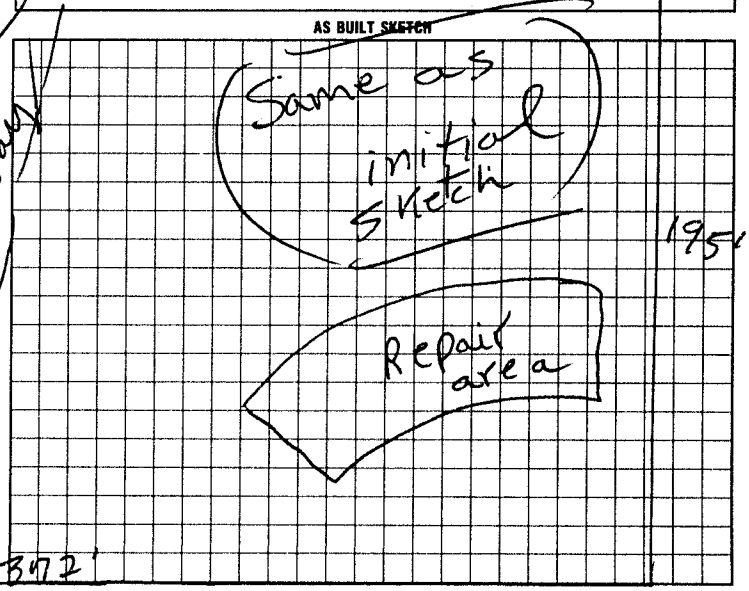

I understand that this permit can be suspended or revoked if any false information is supplied toward securing the permit/any unauthorized changes are made to the site/any unauthorized changes are made in the installation of the system. Improvement Permit with plat valid without expiration. Improvement Permit with site plan valid for sixty months. Authorization to Construct is valid for a period equal to that of Improvement Permit – not to exceed sixty months.

Signed: X _____ date _____ Installed by: Tucker's Grading & Haulings

Improvement Permit by: P. C. moore date 11-19-98 Operation Permit by: P. C. moore date 2-11-99

Authorization to Construct by: P. C. moore date 11-19-98 Existing System Inspection by: _____ date _____

HEALTH DEPT. COPY: WHITE INSPECTION COPY (FINAL): GREEN OWNER COPY (FINAL): YELLOW INSPECTION COPY (INITIAL): PINK OWNER COPY (INITIAL): GOLD