1036

IREDELL COUNTY HEALTH DEPARTMENT

STATESVILLE 704-878-5305 MOORESVILLE 704-664-5281

IMPROVEMENT PERMIT / AUTHORIZATION TO CONSTRUCT / OPERATION PERMIT / EXISTING SYSTEM INSPECTION

PERMIT# 147884 PIN# 4761 33 1124 .027 4761-23-1390 DATE 6/11/08

OWNER OR APPLICANT CORINTHIAN BUILDERS LTD. PHONE: Business 704-400-1258 Home

ADDRESS PO BOX 990 DENVER, NC. 28037

LOCATION QUAIL AMITY TR EMMA RAE TR LOGAN RIDGE TO CUL DESAC, ON (L)

SUBDIVISION WHEATFIELD BLOCK / SECTION 1 LOT 27 LOT AREA .58AC SITE CLASS P3 DESIGN FLOW 360 L.T.A.R. .3

Septic Tank: 1000 Gallons: STB 1186 Date 4/4/08

Pump Tank: 1000 Gallons: PT 32 Date 5/14/08

Pump Make: Goulds Model WE0511HH Serial No.

Nitrification Field: No Fields 1 Square Feet 900 Linear Feet 300

No Lines 5 Trench Width 3' Max Trench Bottom Depth 24

[X] New System [ ] Repair [ ] Expansion System Type: I II III IV V VI

System Description: PM - 25% REDUCTION

Repair System Description: LP - 16" PPBPS

Maintenance Agreement Required: [ ] Yes [X] No

[X] House/Mod. Home [ ] Mobile Home [ ] Business [ ] Other

No. Bedrooms 3 No. Persons No. Employees

Water Supply: [X] Individual [ ] Public [ ] Community

Gravel Depth N/A [ ] Gravity [X] Pressure [ ] Slab [X] Crawl Space [ ] Basement w/plumbing [ ] Basement wo/plumbing

Comments:/Conditions:

FASTTRACK DESIGN + SPECS BY J + EC
CONCORD 704-720-9405

Comments:/Conditions:


INITIAL SITE SKETCH

1) 24" MAXIMUM TRENCH DEPTH

2) ADDITIONAL SUITABLE COVER MATERIAL WILL BE NEEDED TO ENSURE A UNIFORM 6" COVER OVER DRAINFIELD

3) NO CHANGES PERMISSABLE WITHOUT ICHD AUTHORIZATION BEFORE HAND.

AS BUILT SKETCH

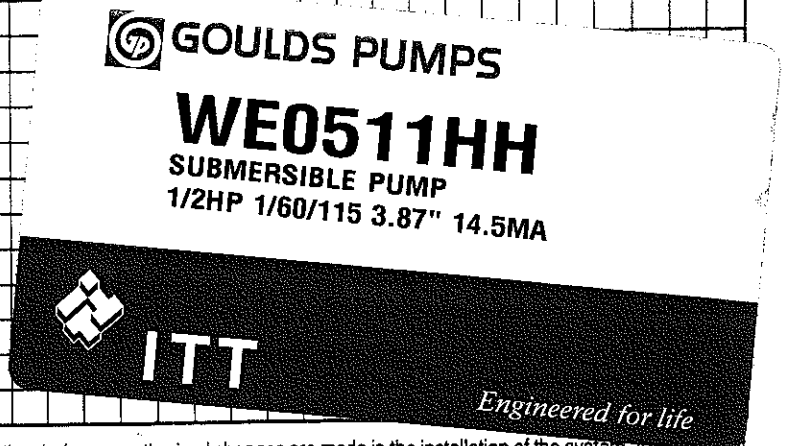

Permit can be suspended or revoked if any false information is supplied toward securing the permit/any unauthorized changes are made to the site/any unauthorized changes are made in the installation of the system. Improvement Authorization to Construct is valid for a period equal to that of Improvement Permit – not to exceed sixty months.

Permit with plat valid without expiration [ ] Improvement Permit with site plan valid for sixty months [X]

Signed: X date 6-11-08

Improvement Permit by: R.S. date 6/11/08


Authorization to Construct by: date 6-11-08

Installed by: Corinthian

Operation Permit by: date 7/22/08

Existing System Inspection by: date

HEALTH DEPT. COPY: WHITE OWNER COPY (FINAL): YELLOW OWNER COPY (INITIAL): PINK

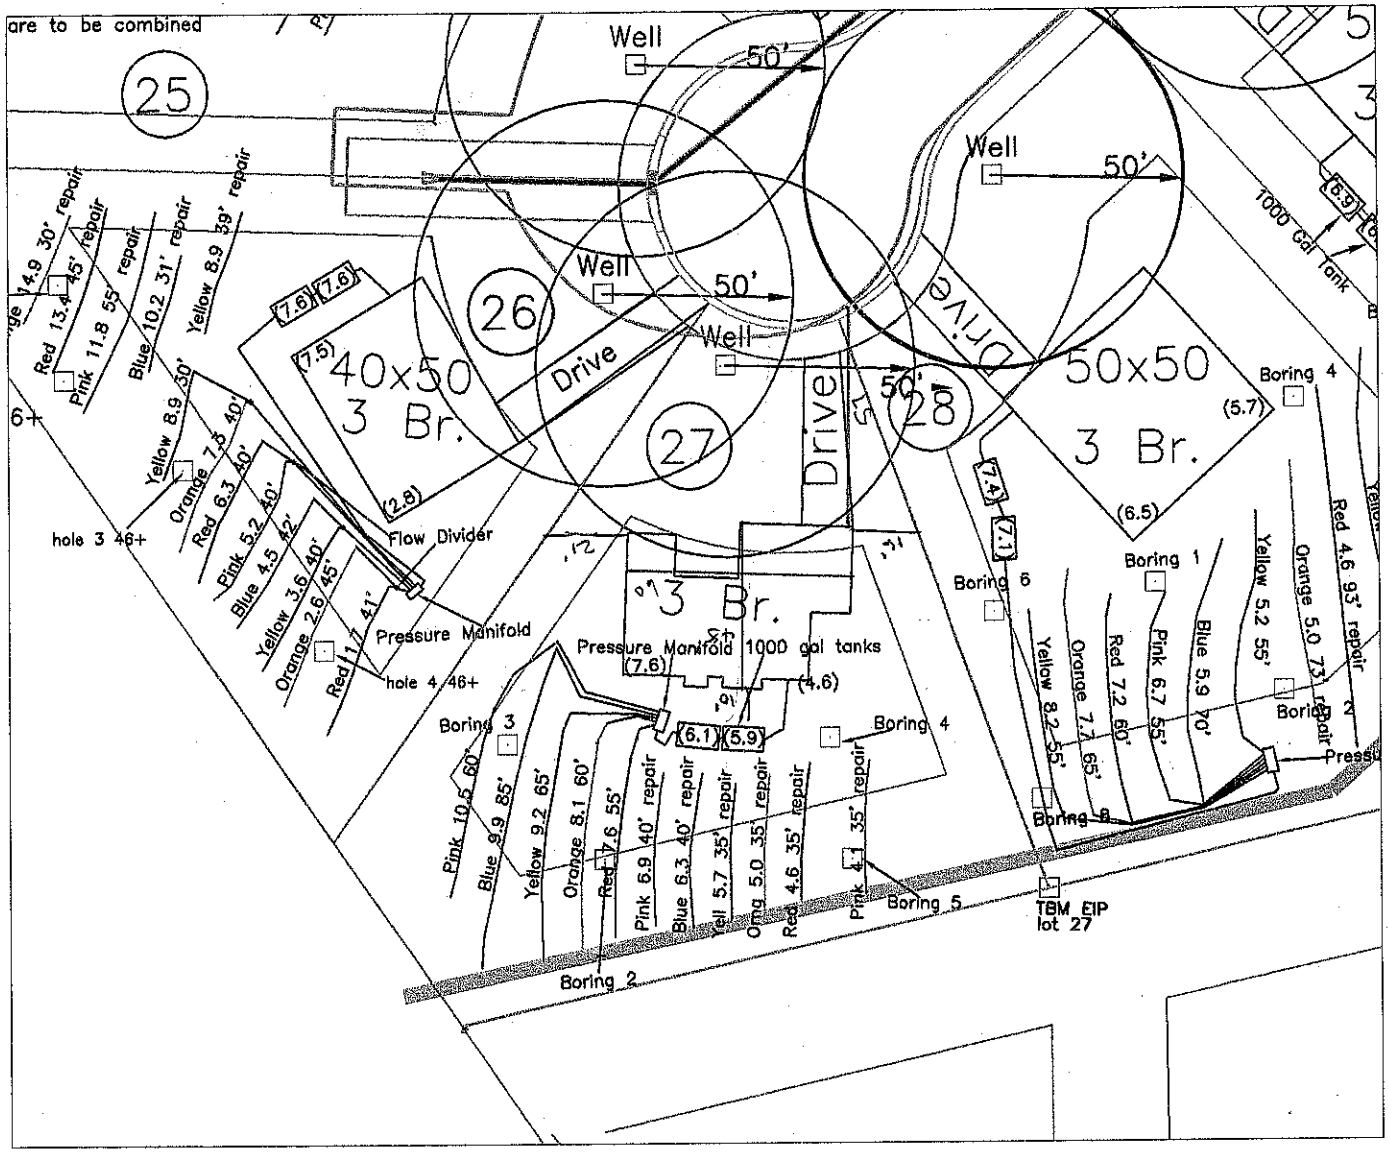

**SUITABLE FOR PRELIMINARY PLANNING PURPOSES ONLY. ALL LOTS WILL REQUIRE APPROVAL BY THE COUNTY HEALTH DEPARTMENT ON A LOT BY LOT BASIS. THIS MAP SHOULD BY USED AS A GENERAL GUIDE, SOME ADJUSTMENTS WILL BE NECESSARY IN THE FIELD DUE TO SOIL VARIABILITY AND TOPOGRAPHIC IRREGULARITIES. THIS MAP ONLY REFLECTS EXISTING SOIL SUITABILITY FOR ON-SITE SEPTIC TANK SYSTEMS. SOME OTHER CONSIDERATIONS THAT AFFECT SITE SUITABILITY THAT SHOULD BE CONSIDERED IN DEVELOPMENT DESIGN ARE:

1) 10' SETBACK FROM PROPERTY LINE
2) 100' SETBACK FROM ANY WELL
3) 50' SETBACK FROM STREAMS, PONDS OR LAKES.

See accompanying S&EC report.

NOT A SURVEY

GRAPHIC SCALE
1" = 50'

50 0 50 100

N

PROJECT NO.	#5-1882
PROJECT MGR.	BF
DRAWN BY	BF
FIELD WORK	BF
SCALE	1" =50
FILE	Y:\jobs\1882

Soil & Environmental Consultants, PA
239 LaPhilip Court, Suite C • Concord, North Carolina 28025 • Phone (704)720-8405 • Fax (704) 720-8406

S&EC

Wheatfield
Cumberland Builders
- Wheatfield lot 27 -
IREDELL COUNTY, NORTH CAROLINA
Jan 2009

SHEET TITLE
PRELIMINARY SITE PLAN
SKETCH MAP

SHEET
1 OF 1