IREDELL COUNTY HEALTH DEPARTMENT

ReadyNow

pd $575.00 10-20-08

STATESVILLE 704-878-5305 MOORESVILLE 704-664-5281

IMPROVEMENT PERMIT / AUTHORIZATION TO CONSTRUCT / OPERATION PERMIT / EXISTING SYSTEM INSPECTION

PERMIT# 147882 PIN# 4761 33 1124 DATE 7/7/08

OWNER OR APPLICANT EL LAGO PHONE: Business 704-400-1258 Home

ADDRESS PO BOX 990 DENVER, N.C. 28037

LOCATION ~~DENVER~~, OSAMITY TR WHEATFIELD TR EMMAMAE TR LOGANRIDGE ONL OFF CUL DESAC

SUBDIVISION WHEATFIELD BLOCK / SECTION LOT 28 LOT AREA .46 SITE CLASS. PS DESIGN FLOW 360 L.T.A.R. .275

Septic Tank: 1000 Gallons: STB 786 Date 4-21-09
Pump Tank: 1000 Gallons: PT 32 Date 9-23-09
Pump Make: GOULDS Model WE0511H Serial No. 1/2 HP
Nitrification Field: No Fields 1 Square Feet 981 Linear Feet 327
No Lines 6 Trench Width 3' Max Trench Bottom Depth 24" Gravel Depth No ☐ Gravity ☒ Pressure ☐ Slab ☒ Crawl Space ☐ Basement w/plumbing ☐ Basement wo/plumbing

☒ New System ☐ Repair ☐ Expansion System Type: I II (III) IV V VI
System Description: AM → 25% REDUCTION
Repair System Description: SAME
Maintenance Agreement Required: ☐ Yes ☒ No

☒ House/Mod. Home No. Bedrooms 3
☐ Mobile Home No. Persons
☐ Business No. Employees
☐ Other


Water Supply: ☒ Individual ☐ Public ☐ Community

Comments/Conditions: (1) MAXIMUM TRENCH DEPTH 24" (2) SITE MUST HAVE REPRESENTATIVE ON SITE FOR CONSULT BEFORE INSTALLATION. (3) NO CHANGES WITHOUT ICHD APPROVAL BEFORE INSTALLATION

Comments/Conditions:

INITIAL SITE SKETCH

FAST TRACK
DESIGN & SPECS BY SITE CONCORD
704-720-9405

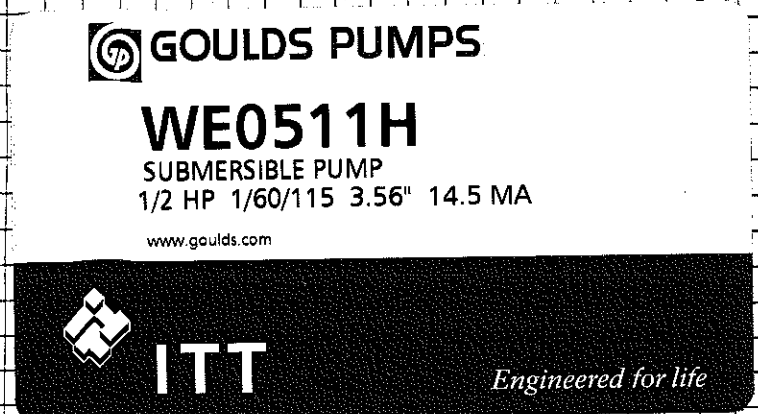

AS BUILT SKETCH

350' INSTALLED

60' LINE 1
60' LINE 2
55' LINE 3
55' LINE 4
60' LINE 5
60' LINE 6

LINES WENT IN BASICALLY AS SHOWN ON PLAT.


Permit can be suspended or revoked if any false information is supplied toward securing the permit/any unauthorized changes are made to the site/any unauthorized changes are made in the installation of the system. Improvement Permit with plat valid without expiration ☐ Improvement Permit with site plan valid for sixty months ☒ Authorization to Construct is valid for a period equal to that of Improvement Permit – not to exceed sixty months.

Signed: X date 10-20-08 Installed by: ADAN GARCIA

Improvement Permit by: RS date 7/7/08 Operation Permit by: RS date 1-14-09

Authorization to Construct by: RS date 10-19-09 Existing System Inspection by: date

HEALTH DEPT. COPY: WHITE OWNER COPY (FINAL): YELLOW OWNER COPY (INITIAL): PINK

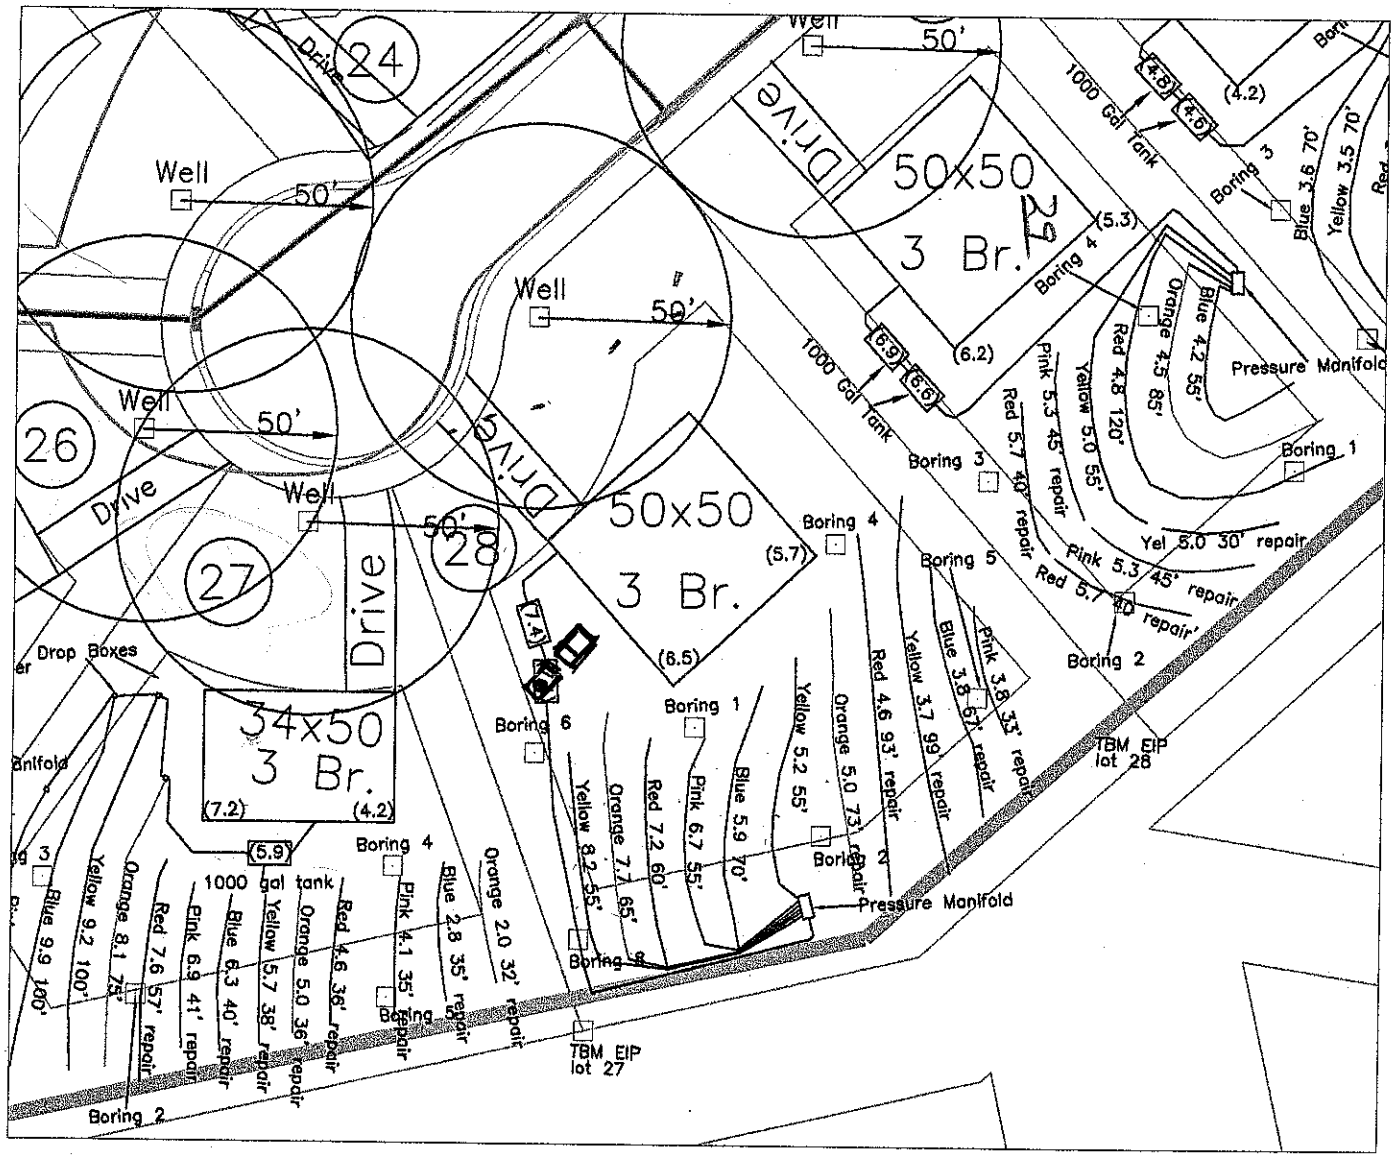

**SUITABLE FOR PRELIMINARY PLANNING PURPOSES ONLY. ALL LOTS WILL REQUIRE APPROVAL BY THE COUNTY HEALTH DEPARTMENT ON A LOT BY LOT BASIS. THIS MAP SHOULD BY USED AS A GENERAL GUIDE, SOME ADJUSTMENTS WILL BE NECESSARY IN THE FIELD DUE TO SOIL VARIABILITY AND TOPOGRAPHIC IRREGULARITIES.
THIS MAP ONLY REFLECTS EXISTING SOIL SUITABILITY FOR ON-SITE SEPTIC TANK SYSTEMS. SOME OTHER CONSIDERATIONS THAT AFFECT SITE SUITABILITY THAT SHOULD BE CONSIDERED IN DEVELOPMENT DESIGN ARE:

1) 10' SETBACK FROM PROPERTY LINE
2) 100' SETBACK FROM ANY WELL
3) 50' SETBACK FROM STREAMS, PONDS OR LAKES.

See accompanying S&EC report.

NOT A SURVEY

GRAPHIC SCALE
1" = 50'

50 0 50 100

PROJECT NO
#5-1882
PROJECT MGR
BP
DRAWN BY
BP
FIELD WORK
BP
SCALE
1" =50
FILE
Y:\jobs\1882

Soil & Environmental Consultants, PA
235 Lafferty Court, Suite C • Concord, North Carolina 28025 • Phone (704)720-9405 • Fax (704) 720-9406

S&EC

Wheatfield — Geotechnical Studies — - Wheatfield lot 28 -

SHEET TITLE:
PRELIMINARY SITE PLAN SKETCH MAP

SHEET
1 OF