IREDELL COUNTY HEALTH DEPARTMENT

STATESVILLE 704-878-5305 MOORESVILLE 704-664-5281

IMPROVEMENT PERMIT / AUTHORIZATION TO CONSTRUCT / OPERATION PERMIT / EXISTING SYSTEM INSPECTION

DATE 4/24/08

PERMIT# 14878 PIN# 4761 33 24.029 4761-23-4403

OWNER OR APPLICANT Corinthian Builders, Ltd. PHONE: Business 704 400-1258 Home

ADDRESS PO Box 990 Denver, NC 28037

LOCATION Hwy 21 N TR Oswalt Amity TR Wheatfield to Logan Ridge Dr.

SUBDIVISION Wheatfield BLOCK / SECTION 1 LOT 29 LOT AREA .58ac SITE CLASS PS DESIGN FLOW 360 L.T.A.R. .3

Septic Tank: 1000 Gallons; STB 786 Date 3-1-07

Pump Tank: 1000 Gallons; PT 32 Date 4-20-08

Pump Make: Gould Model WE0511HH Serial No.

Nitrification Field: No Fields 1 Square Feet 945 Linear Feet 315'

No Lines 4 Trench Width 36" Max Trench Bottom Depth 24"

☑ New System ☐ Repair ☐ Expansion System Type: ☐ I ☐ II ☐ III ☐ IV ☐ V ☐ VI

System Description: PM-25% Reduction

Repair System Description: LP-PPBPS

Maintenance Agreement Required: ☐ Yes ☑ No Initial

☑ House/Mod. Home ☐ Mobile Home ☐ Business ☐ Other

No. Bedrooms 3 No. Persons No. Employees

Water Supply: ☑ Individual ☐ Public ☐ Community

Gravel Depth N/A ☐ Gravity ☑ Pressure ☐ Slab ☑ Crawl Space ☐ Basement w/plumbing ☐ Basement wo/plumbing

Comments:/Conditions: 24" Max depth *
Need final plat recorded and received before A.C.

Comments:/Conditions:

INITIAL SITE SKETCH

by. SSEC

AS BUILT SKETCH

For 55' Line Installed as AZ Flow 1308
Filter or Block 4 Installed for other 3 lines

55' 120' 55' end of line

PT 5FT

10'

House

35 70'

35'

any false information is supplied toward securing the permit/any unauthorized changes are made to the site/any unauthorized changes are made in the installation of the system. Improvement Authorization to Construct is valid for a period equal to that of Improvement Permit – not to exceed sixty months.

☐ Improvement Permit with site plan valid for sixty months ☑

Authorization to Construct by: date 4-28-08

date 4/24/08


date 6-11-08


Installed by: Corinthian

Operation Permit by: Ramsey date 9/4/08

Existing System Inspection by: date

HEALTH DEPT. COPY: WHITE OWNER COPY (FINAL): YELLOW OWNER COPY (INITIAL): PINK

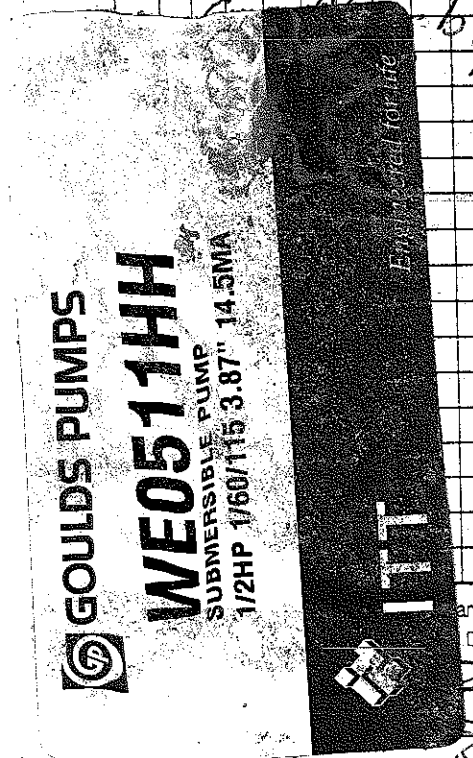

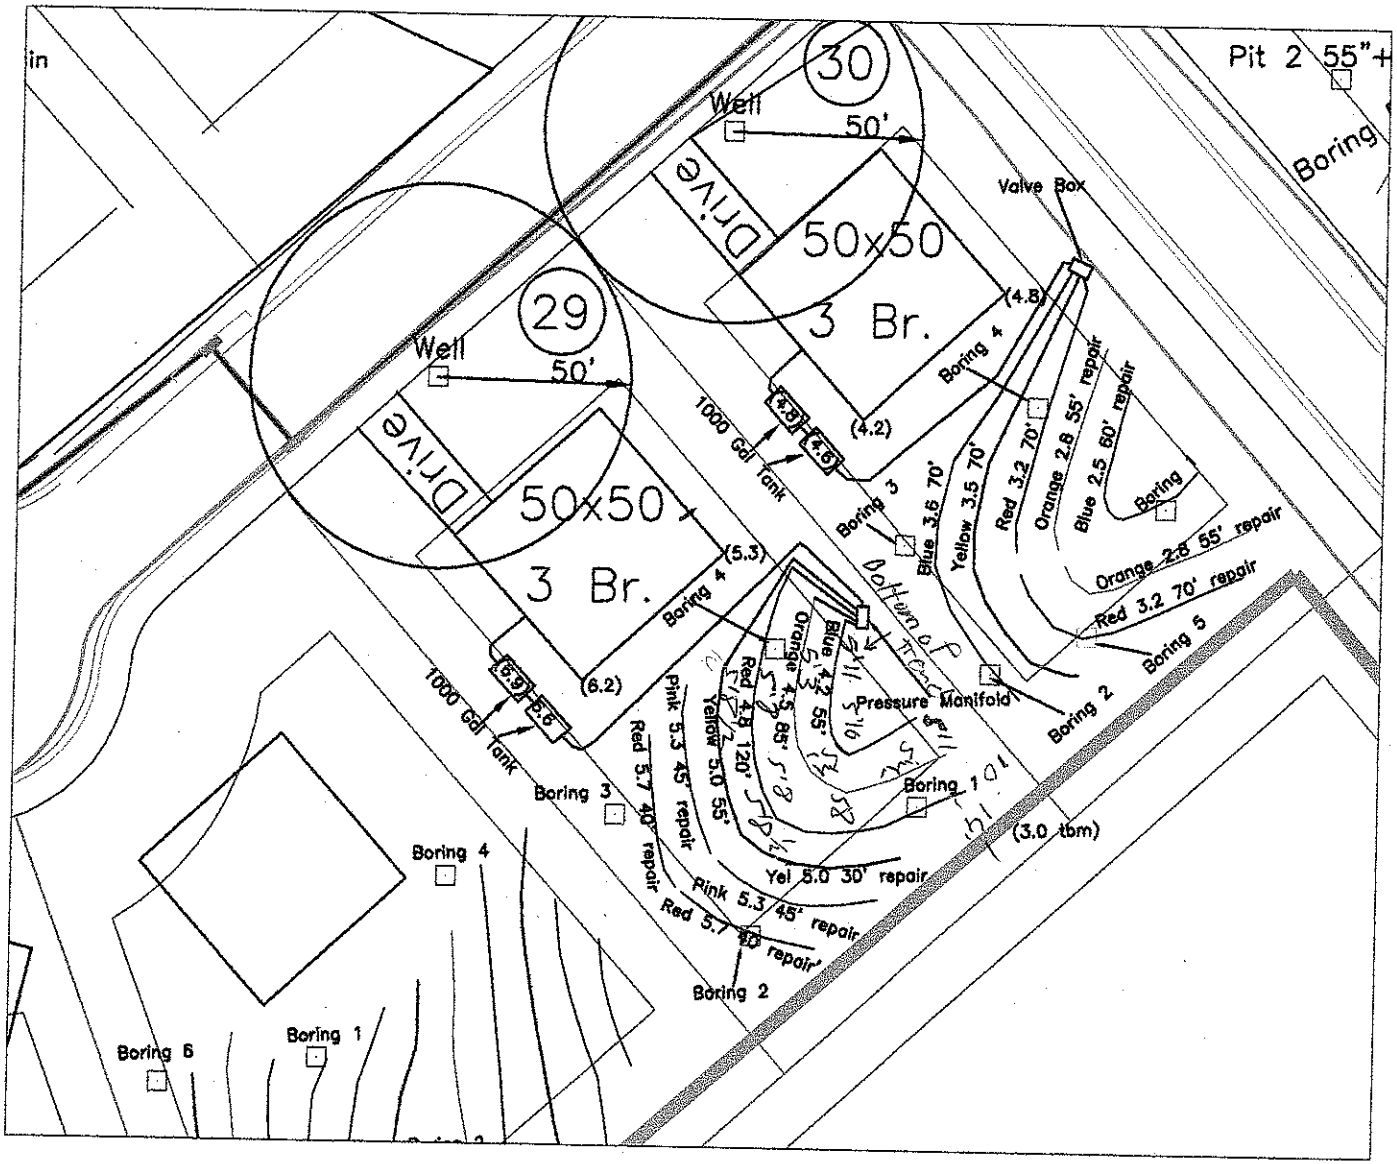

**SUITABLE FOR PRELIMINARY PLANNING PURPOSES ONLY. ALL LOTS WILL REQUIRE APPROVAL BY THE COUNTY HEALTH DEPARTMENT ON A LOT BY LOT BASIS. THIS MAP SHOULD BY USED AS A GENERAL GUIDE, SOME ADJUSTMENTS WILL BE NECESSARY IN THE FIELD DUE TO SOIL VARIABILITY AND TOPOGRAPHIC IRREGULARITIES.
THIS MAP ONLY REFLECTS EXISTING SOIL SUITABILITY FOR ON-SITE SEPTIC TANK SYSTEMS. SOME OTHER CONSIDERATIONS THAT AFFECT SITE SUITABILITY THAT SHOULD BE CONSIDERED IN DEVELOPMENT DESIGN ARE:

1) 10' SETBACK FROM PROPERTY LINE
2) 100' SETBACK FROM ANY WELL
3) 50' SETBACK FROM STREAMS, PONDS OR LAKES.

See accompanying S&EC report.

NOT A SURVEY

GRAPHIC SCALE
1" = 50'

50 0 50 100

PROJECT NO. #5-1882
PROJECT MG BF
DRAWN BY BF
FIELD WORK BF
SCALE 1" =50
FILE Y:\jobs\1882

Soil & Environmental Consultants, PA
235 Lafferty Creek, Suite C • Concord, North Carolina 28025 • Phone (704)720-4820 • Fax (704) 720-4498

S&EC

Wheatfield Crestview Builders - Wheatfield lot 29 -

SHEET TITLE: PRELIMINARY SITE PLAN SKETCH MAP

SHEET OF