IREDELL COUNTY HEALTH DEPARTMENT

STATESVILLE 704-878-5305 MOORESVILLE 704-664-5281

IMPROVEMENT PERMIT / AUTHORIZATION TO CONSTRUCT / OPERATION PERMIT / EXISTING SYSTEM INSPECTION

PERMIT# 147908 PIN# ~~4761 33 1124~~ 4761 23 4874 DATE 10/27/08

OWNER OR APPLICANT Corinthian Bldrs LTD. PHONE: Business 704-400-1258 Home

ADDRESS PO Box 990 Denver, NC. 28037

LOCATION Us Hwy 8 TR Wheatfield TR 2ND Street TR, 2ND lot on R

SUBDIVISION Wheatfield BLOCK / SECTION LOT 20 LOT AREA .50 Ac SITE CLASS PS DESIGN FLOW 360 L.T.A.R. .3

Septic Tank: 1000 Gallons; STB Eco Date 5-14-08

Pump Tank: 1000 Gallons; PT 32 Date 9/8/07

Pump Make: Goulds Model WFG511HH Serial No.

Nitrification Field: No Fields 1 Square Feet 600 Linear Feet 200

No Lines 4 Trench Width 3' Max Trench Bottom Depth 3'

[X] New System [ ] Repair [ ] Expansion System Type: I II III (IV) V VI

System Description: LP-16" PPBPS

Repair System Description: SAME TYPE

Maintenance Agreement Required: [X] Yes [ ] No

Gravel Depth NA [ ] Gravity [X] Pressure [ ] Slab [X] Crawl Space [ ] Basement w/plumbing [ ] Basement wo/plumbing

[X] House/Mod. Home No. Bedrooms 3

[ ] Mobile Home No. Persons

[ ] Business No. Employees

[ ] Other


Water Supply: [X] Individual [ ] Public [ ] Community

Comments:/Conditions: (1) Maintenance Contract Required (2) NO Changes without written permission from IC HD (3) Used 5/32" holes

Comments:/Conditions: blue folder

(1" = 50')

INITIAL SITE SKETCH

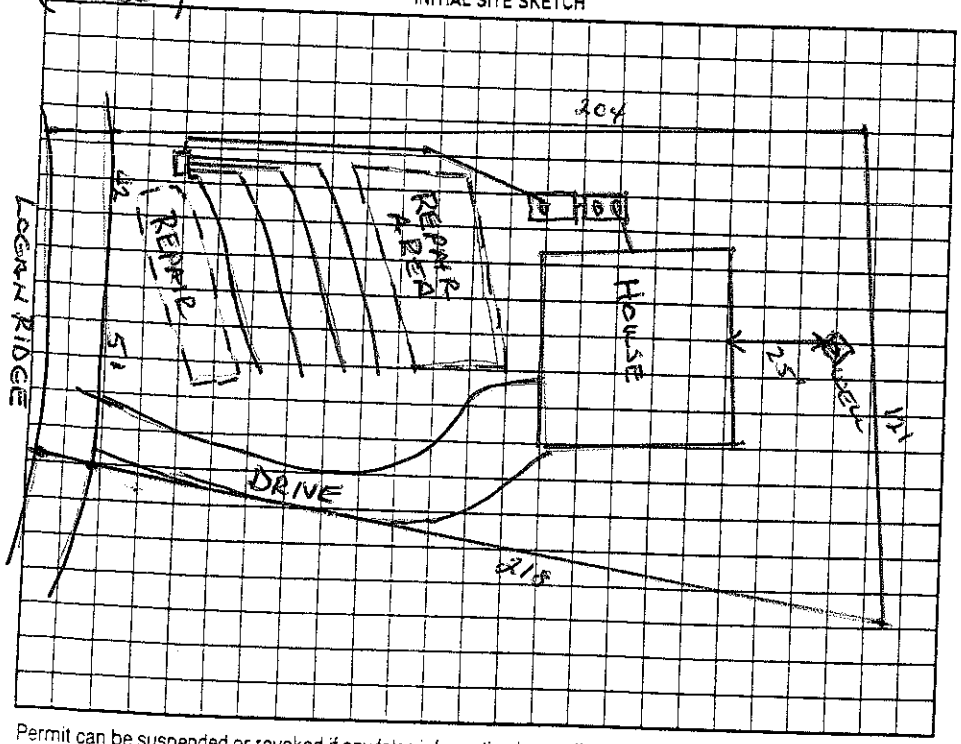

AS BUILT SKETCH

	Date	Initials
Drain Lines Checked	1/27/09	RM
Tanks Checked	1/26/09	RM
Pressure Manifold or Valve Box Checked	1/26/09	RM
Pressure Head Set	3/31/09	RM
Electrical Checked	3/31/09	RM
Floats Set	3/31/09	RM
Alarm Checked	3/31/09	RM
Maintenance Contract Y / N	4/27/09	RM

Permit can be suspended or revoked if any false information is supplied toward securing the permit/any unauthorized changes are made to the site/any unauthorized changes are made in the installation of the system. Improvement Permit with plat valid without expiration [ ] Improvement Permit with site plan valid for sixty months [X] Authorization to Construct is valid for a period equal to that of Improvement Permit – not to exceed sixty months.

Signed: [signature] date 11-24-08

Improvement Permit by: Wesley Sparks RS date 10/27/08

Authorization to Construct by: Wesley Sparks RS date 10/27/08

Installed by: Corinthian

Operation Permit by: [signature] date 4/27/09

Existing System Inspection by: date

HEALTH DEPT. COPY: WHITE OWNER COPY (FINAL): YELLOW OWNER COPY (INITIAL): PINK

IREDELL COUNTY HEALTH DEPARTMENT

STATESVILLE 704-878-5305 MOORESVILLE 704-664-5281

IMPROVEMENT PERMIT / AUTHORIZATION TO CONSTRUCT / OPERATION PERMIT / EXISTING SYSTEM INSPECTION

PERMIT# 147908 PIN# 4761 33 1124 4761 23 4614 DATE 10/27/08

OWNER OR APPLICANT Corinthian Bldrs LTD. PHONE: Business 704-400-1258 Home

ADDRESS PO Box 990 Denver, NC. 28037

LOCATION On unit TR Wheatfield TR 2ND Street TR, 2ND lot on (R)

SUBDIVISION Wheatfield BLOCK / SECTION / LOT 20 LOT AREA .50Ac SITE CLASS. PS DESIGN FLOW 360 L.T.A.R. .3

Septic Tank: 1000 Gallons: STB TBD Date 5-MAY-08

Pump Tank: 1000 Gallons: PT 32 Date 9/8/08

Pump Make: Goulds Model WFG611HH Serial No.

Nitrification Field: No Fields 1 Square Feet 600 Linear Feet 200

No Lines 4 Trench Width 3' Max Trench Bottom Depth 3'

[X] New System [ ] Repair [ ] Expansion System Type: I II III (IV) V VI

System Description: LP-1L" PPBPS

Repair System Description: SAME TYPE

Maintenance Agreement Required: [X] Yes [ ] No

Gravel Depth NA [ ] Gravity [X] Pressure [ ] Slab [X] Crawl Space [ ] Basement w/plumbing [ ] Basement wo/plumbing

[X] House/Mod. Home [ ] Mobile Home [ ] Business [ ] Other


No. Bedrooms 3 No. Persons No. Employees

Water Supply: [X] Individual [ ] Public [ ] Community


Comments:/Conditions: 1) Maintenance Contract Required 2) NO Changes without written permission from ICHD 3) Used 5/32" holes

Comments:/Conditions:

INITIAL SITE SKETCH (1" = 50')

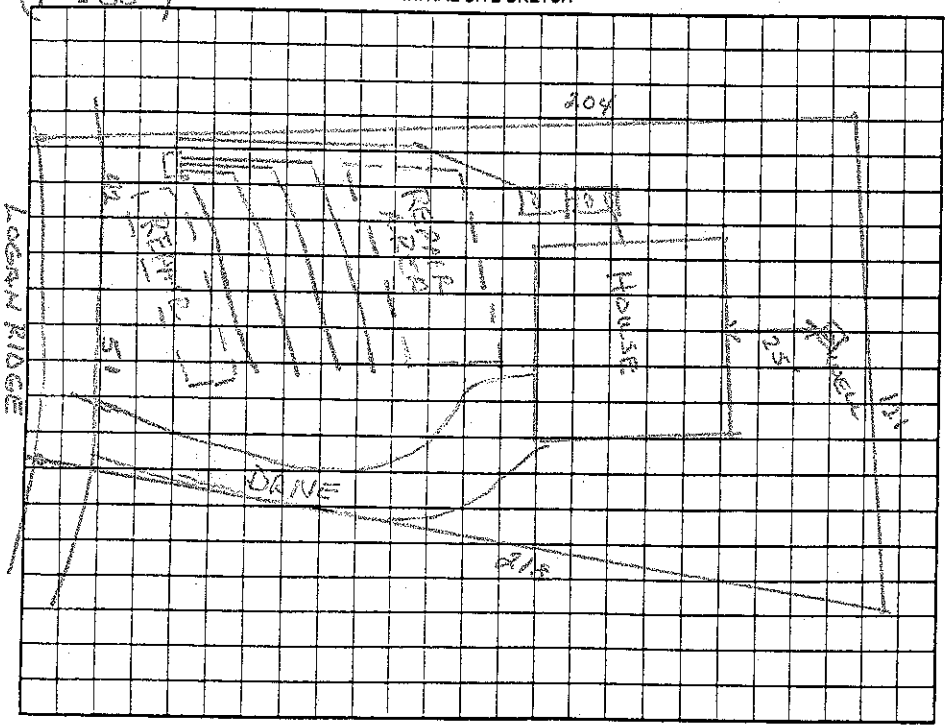

AS BUILT SKETCH

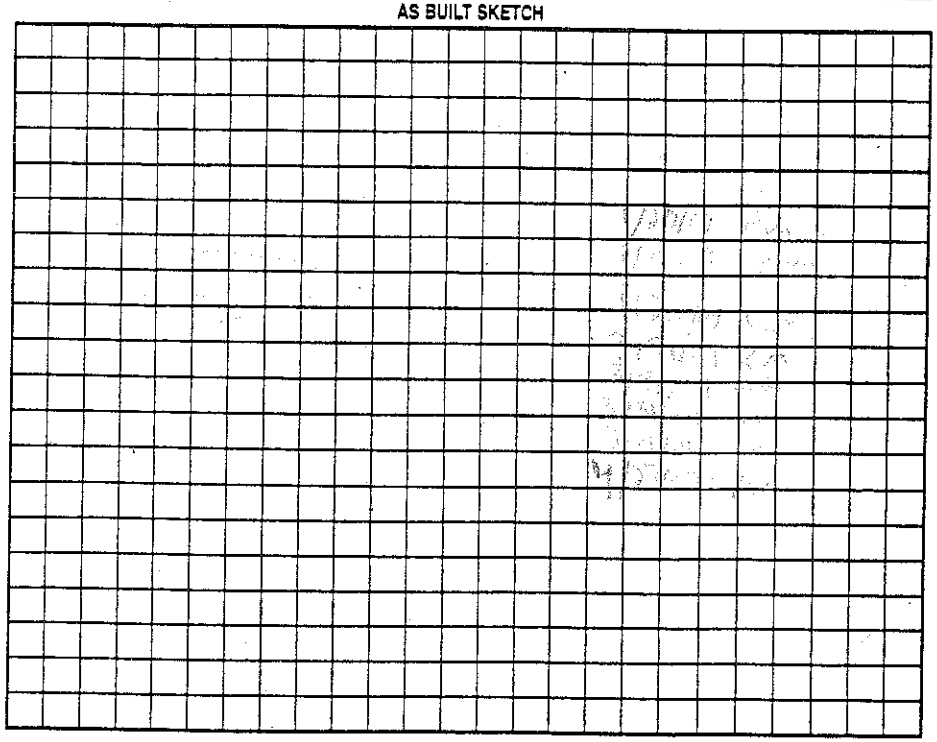

Permit can be suspended or revoked if any false information is supplied toward securing the permit/any unauthorized changes are made to the site/any unauthorized changes are made in the installation of the system. Improvement Permit with plat valid without expiration [ ] Improvement Permit with site plan valid for sixty months [X] Authorization to Construct is valid for a period equal to that of Improvement Permit – not to exceed sixty months.

Signed: [signature] date 11-24-08

Improvement Permit by: Wesley Sparks R.S. date 10/27/08

Authorization to Construct by: Wesley Sparks R.S. date 10/27/08

Installed by: Corinthian

Operation Permit by: [signature] date 4/27/09

Existing System Inspection by: date

HEALTH DEPT. COPY: WHITE OWNER COPY (FINAL): YELLOW OWNER COPY (INITIAL): PINK