2:30 Owes 575.00

IREDELL COUNTY HEALTH DEPARTMENT

STATESVILLE 704-878-5305 MOORESVILLE 704-664-5281

IMPROVEMENT PERMIT / AUTHORIZATION TO CONSTRUCT / OPERATION PERMIT / EXISTING SYSTEM INSPECTION

PERMIT# 147440 PIN# ~~4761331244033~~ 4761238636.000 DATE 4/24/08

OWNER OR APPLICANT Corinthian Builders Ltd. / EL Legg LLC PHONE: Business 704 400-1258 Home

ADDRESS PO Box 990 Denver NC 28037

LOCATION Hwy 21 N TL Oswalt Amity TR Wheatfield TL Emma Mae Dr. TR Logan Ridge Lot on Left

SUBDIVISION Wheatfield BLOCK / SECTION LOT 33 LOT AREA .51 SITE CLASS. PS DESIGN FLOW 360 L.T.A.R. .275

Septic Tank: 1000 Gallons: STB 1816 Date 7-9-09
Pump Tank: 1000 Gallons: PT 32 Date 8-17-08
Pump Make: GOULDS Model WE0511H Serial No. 1/2 HP
Nitrification Field: No. fields 1 Square Feet 1320 Linear Feet 440'
No Lines 4@110' Trench Width 36" Max Trench Bottom Depth * 24" Gravel Depth 12"

☑ New System ☐ Repair System Type: I II III IV V VI
System Description: PM - Conventional
Repair System Description: PM - 25% Reduction
Maintenance Agreement Required: ☐ Yes ☑ No

☑ House/Mod. Home No. Bedrooms 3
☐ Mobile Home No. Persons
☐ Business No. Employees
☐ Other

Water Supply: ☑ Individual ☐ Public ☐ Community

☐ Gravity ☑ Pressure ☐ Slab ☑ Crawl Space ☐ Basement w/plumbing ☐ Basement wo/plumbing

Comments:/Conditions: * 24" max depth
~~No final plat recorded received before AE~~
* Approved 25% Reduction System may be used as initial System.

INITIAL SITE SKETCH

See plans by SREC

GOULDS PUMPS
WE0511H
SUBMERSIBLE PUMP
1/2HP 1/60/115 3.56" 14.5MA

ITT Engineered for life

Comments:/Conditions: garage has been moved to left side 4/9/09 AC

AS BUILT SKETCH

1) QUICK H INSTALLED
2) PUMP SYSTEM INSTALLED AS SHOWN ON ATTACHED PLAN
3) CHECKED TANKS, DRAIN LINES + PM 8-19-09
4) CHECKED ELECTRICAL + ALARM 10-8-09 BA

INSTALLED AT 24"


Permit can be suspended or revoked if any false information is supplied toward securing the permit/any unauthorized changes are made to the site/any unauthorized changes are made in the installation of the system. Improvement Permit with plat valid without expiration ☐ Improvement Permit with site plan valid for sixty months ☑ Authorization to Construct is valid for a period equal to that of Improvement Permit – not to exceed sixty months.

Signed: _____ date 4-24-08 Installed by: ADAN

Improvement Permit by: Anthony Cober Jr. date 4/24/08 Operation Permit by: R. A. date 10-8-09

Authorization to Construct by: Robin date 4/9/09 Existing System Inspection by: _____ date _____

HEALTH DEPT. COPY: WHITE OWNER COPY (FINAL): YELLOW OWNER COPY (INITIAL): PINK

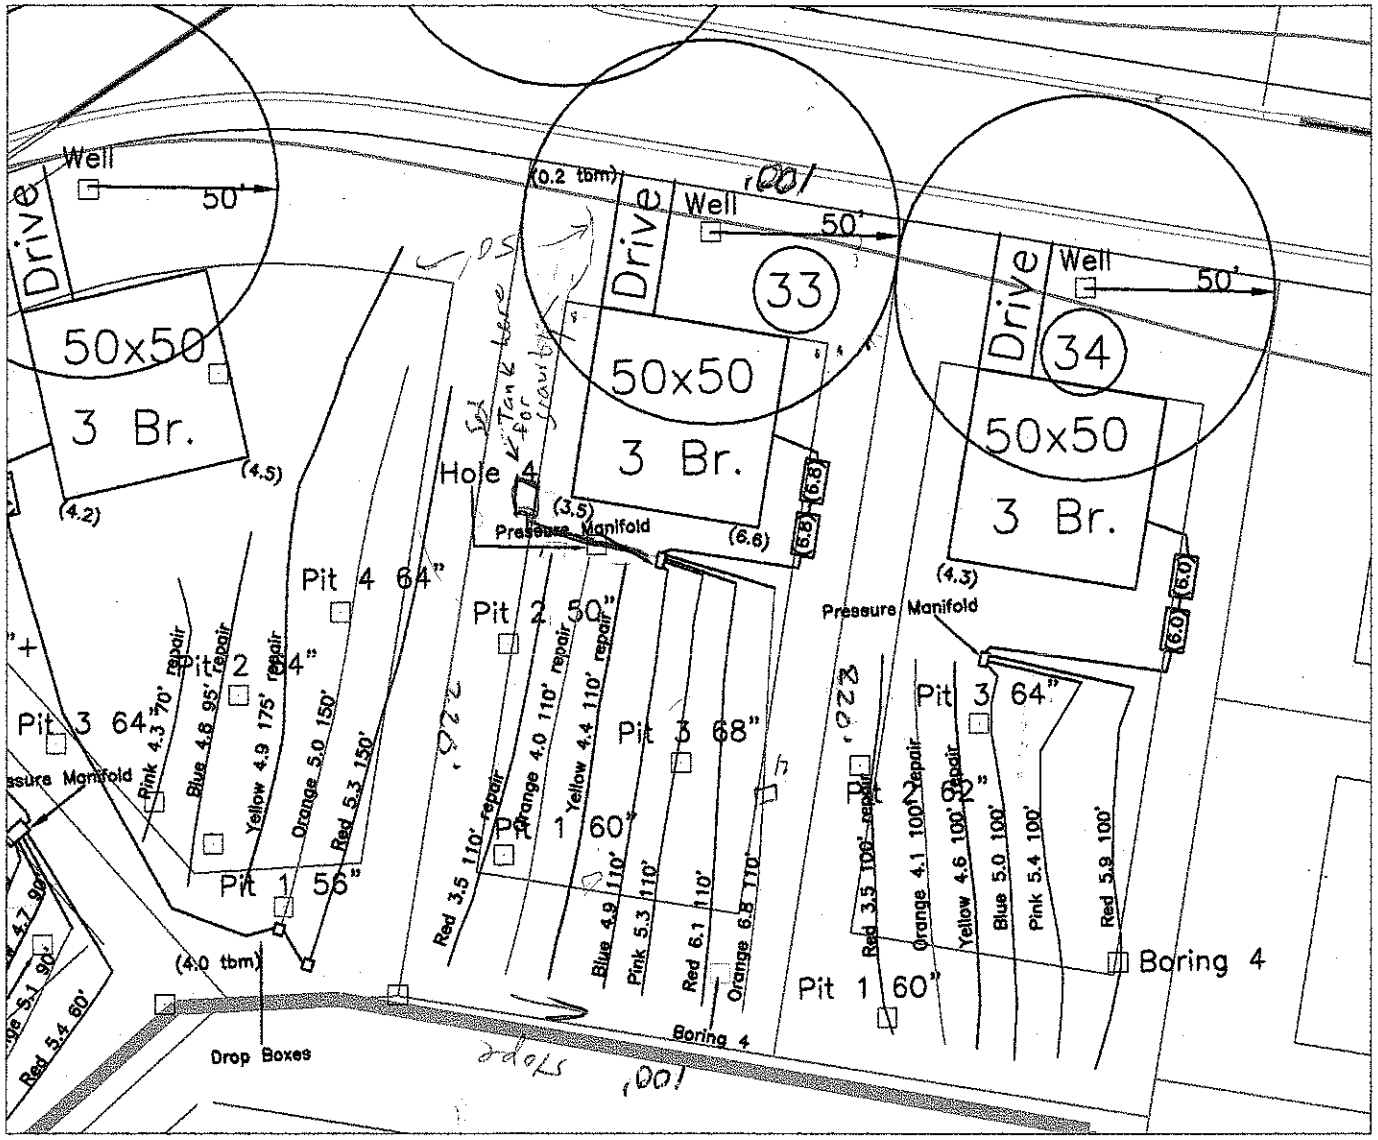

**SUITABLE FOR PRELIMINARY PLANNING PURPOSES ONLY. ALL LOTS WILL REQUIRE APPROVAL BY THE COUNTY HEALTH DEPARTMENT ON A LOT BY LOT BASIS. THIS MAP SHOULD BY USED AS A GENERAL GUIDE, SOME ADJUSTMENTS WILL BE NECESSARY IN THE FIELD DUE TO SOIL VARIABILITY AND TOPOGRAPHIC IRREGULARITIES.
THIS MAP ONLY REFLECTS EXISTING SOIL SUITABILITY FOR ON-SITE SEPTIC TANK SYSTEMS. SOME OTHER CONSIDERATIONS THAT AFFECT SITE SUITABILITY THAT SHOULD BE CONSIDERED IN DEVELOPMENT DESIGN ARE:

1) 10' SETBACK FROM PROPERTY LINE
2) 100' SETBACK FROM ANY WELL
3) 50' SETBACK FROM STREAMS, PONDS OR LAKES.

See accompanying S&EC report.

NOT A SURVEY

GRAPHIC SCALE
1" = 50'

50 0 50 100

PROJECT NO: #6-1862
PROJECT MGR: BF
DRAWN BY: BF
FIELD WORK: BF
SCALE: 1" =50
FILE: Y:\Jobs\1886

Soil & Environmental Consultants, PA
228 Lamm Court, Suite C • Concord, North Carolina 28025 • Phone (704)792-9005 • Fax (704) 792-9009

S&EC

Wheatfield — Corinthian Estates — Wheatfield lot 33

SHEET TITLE: PRELIMINARY SITE PLAN SKETCH MAP

SHEET 1 OF