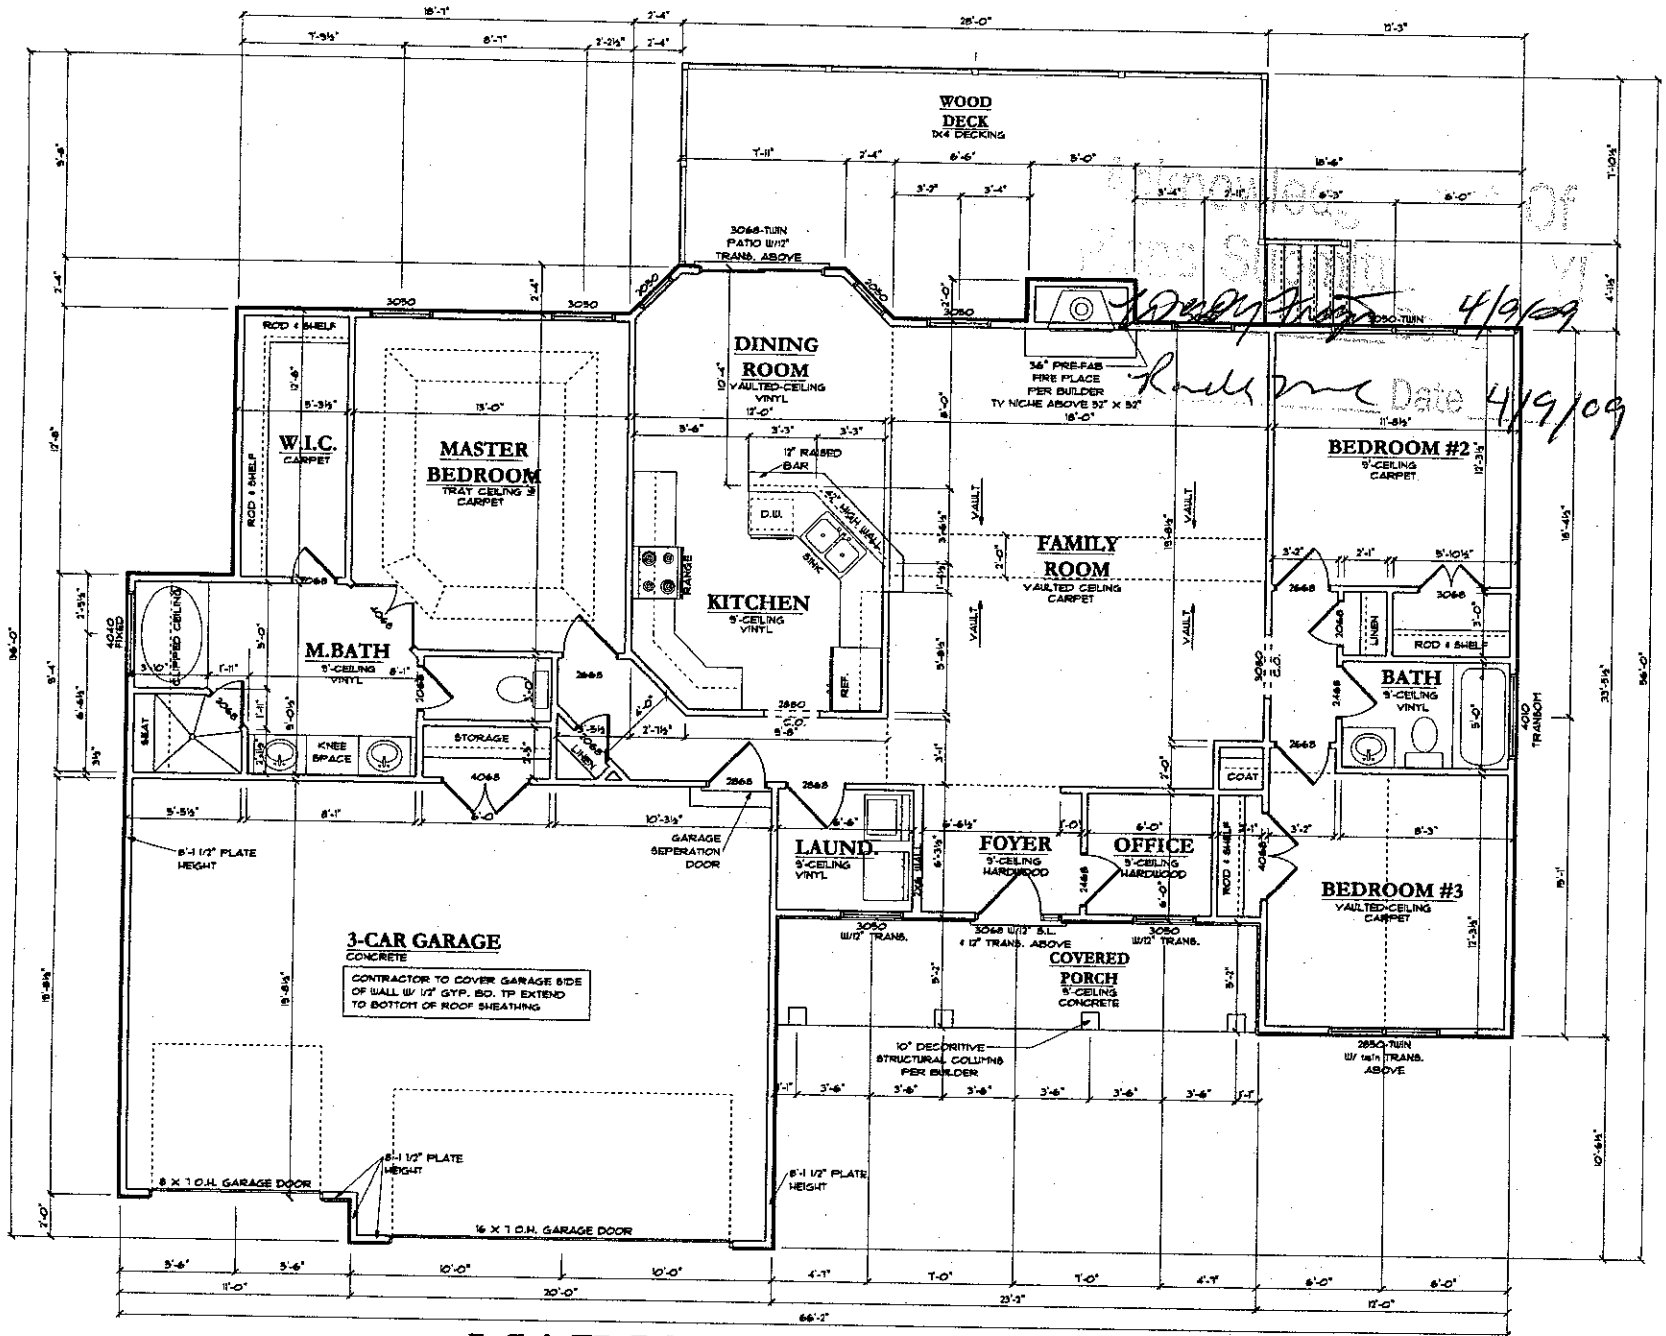


MAIN FLOOR PLAN

SCALE: 1/4" = 1'-0"

Approved Subject to Corrections Noted
Kirby Shaw 4/9/09
Randy Date 4/9/09

Lines by Design or Tracy T. Sipe assumes no liability for any home constructed from this plan. Release of these plans contemplates further cooperation among the owner and his contractor. Changes made from these plans without consent of the designer of record relieves the designer of responsibility for errors and shall relieve the owner from any liability thereafter incurred and shall relieve the designer of responsibility for errors and shall relieve the changes. Written dimensions on these drawings shall govern. Do not scale drawings. Any construction errors caused by scaling out of such dimensions over scaled dimensions, contractor shall verify and be responsible for all dimensions and conditions on the job.

Corinthian Builders Inc.
"The Bailey #2"

Lines By Design, LLC
P.O.Box 1480
Lincolnton, NC 28093
704-201-6410 (Cell)
704-732-8151 (Fax)

Main Floor Plan	
Date: 3-29-09	Project #: 09-0005
Scale: 1/4" = 1'-0"	Sheet: A-4
Drawn By: TTS	