4761 23 9816

IREDELL COUNTY HEALTH DEPARTMENT

STATESVILLE 704-878-5305 MOORESVILLE 704-664-5281

IMPROVEMENT PERMIT / AUTHORIZATION TO CONSTRUCT / OPERATION PERMIT / EXISTING SYSTEM INSPECT.

PERMIT# [redacted] 158338 PIN# ~~4761331124.070~~ DATE 2-6-08

OWNER OR APPLICANT ~~Corinthian Builders, Ltd~~ / Ellago LLC PHONE: Business 704-400-1258 Home

ADDRESS P.O. Box 990 Denver NC 28037

LOCATION Hwy 24 N TR Oswalt Amity TR Wheatfield TR Emma Mae on left

SUBDIVISION Wheatfield BLOCK / SECTION LOT 70 LOT AREA .53 Ac SITE CLASS PS DESIGN FLOW 360gpd L.T.A.R. .275 gpd/ft2

Septic Tank: 1000 Gallons; STB 786 Date 6/2/09

Pump Tank: 1000 Gallons; PT 32 Date 7/11/09

Pump Make: Goulds Model WE0-511H Serial No. 8/09

Nitrification Field: No Fields 1 Square Feet 1014 Linear Feet 338

No Lines 3 Trench Width 36" Max Trench Bottom Depth 24" Gravel Depth N/A ☐ Gravity ☒ Pressure

☒ New System ☐ Repair ☐ Expansion System Type: I II III IV V VI

System Description: 25% reduction pm

Repair System Description: LP PPBPS

Maintenance Agreement Required: ☐ Yes ☒ No

☒ House/Mod. Home ☐ Mobile Home ☐ Business ☐ Other

No. Bedrooms 3 No. Persons 6 No. Employees

Water Supply: ☒ Individual ☐ Public ☐ Community

☐ Slab ☒ Crawl Space ☐ Basement w/plumbing ☐ Basement wo/plumbing

Comments:/Conditions:

See pressure manifold details for varying tap sizes

Comments:/Conditions: 9/21/09 Reviewed Floor plan & Site plan in Compliance with original plan

	Date	Initials
Drain Lines Checked	11/5	WS
Tanks Checked	11/5	WS
Pressure Manifold or Valve Box Checked	11/5	WS
Pressure Head Set	11-25	
Electrical Checked	11-25	
Floats Set	11-25	
Alarm Checked	11-25	
Maintenance Contract Y / N		


10:00

SITE SKETCH

pm SYEC

CHECKED PHEAD, ALARM ELEC FLOATS 11-25-09

AS BUILT SKETCH

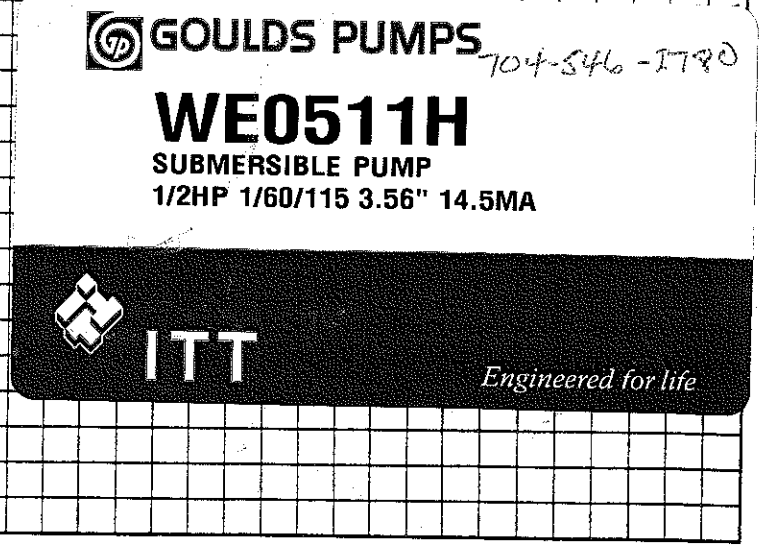

Permit can be suspended or revoked if any false information is supplied toward securing the permit/any unauthorized changes are made to the site/any unauthorized changes are made in the installation of the system. Improvement Permit with plat valid without expiration ☐ Improvement Permit with site plan valid for sixty months ☒ Authorization to Construct is valid for a period equal to that of Improvement Permit – not to exceed sixty months.

Signed: date 3/4/08

Improvement Permit by: date 2-6-08

Authorization to Construct by: date 9/21/09

Installed by: ADON

Operation Permit by: REHS date 11-25-09

Existing System Inspection by: date

HEALTH DEPT. COPY: WHITE OWNER COPY (FINAL): YELLOW OWNER COPY (INITIAL): PINK