160323

FRALO TANK 12:30

IREDELL COUNTY HEALTH DEPARTMENT

STA E 704-878-5305 MOORESVILLE 704-664-5281

IMPROVEMENT PERMIT / AUTHORIZATION TO CONSTRUC. , OPERATION PERMIT / EXISTING SYSTEM INSPECTION

PERMIT # 147392 PIN # 4761-24-2202 DATE 3-9-10

OWNER or APPLICANT JOHN EAGAN PHONE: Business 704-528-0021 Home:

OWNER or APPLICANT ADDRESS PO BOX 1159 TROUTMAN, NC 28166

LOCATION / DIRECTIONS OSWALT AMITY, TR WHEATFIELD, ON L

SUBDIVISION WHEATFIELD BLOCK / SECTION LOT # 79 LOT AREA .51 DESIGN FLOW 360 GPD L.T.A.R. .25

Septic Tank 1000 Gallons: STB 1886 Date 2-10-10

Pump Tank 1000 Gallons: PT 32 Date 10-1-09

Pump Make WE0511H Model GOULDS Serial # 1/2HP

Nitrification Field No Fields 1 No Lines 5 Linear Feet 400'

Trench Width 36" Max. Trench Bottom Depth 24" Gravel Depth —

☒ New System ☐ Repair ☐ Expansion System Type I II III IV V VI

System Description: PM-25% REDUCTION

Repair System Description: LP- PANEL BLOCK

Maintenance Agreement Required ☒ YES ☐ NO INITIALLY

☐ GRAVITY ☒ PRESSURE

☒ Residence No. Bedrooms 3 ☐ Business No. Persons ☐ Other No. Employees ☐ Slab ☒ Crawl Space ☐ Basement w/plumbing ☐ Basement w/o plumbing


Water Supply: ☒ Private ☐ Public ☐ Community

Comments / Conditions 1) FOLLOW ALL STATE REGULATIONS
2) SEE PLAN FROM SEEC

Comments / Conditions
SET PRESSURE HEAD @ 2"


INITIAL SITE SKETCH

400' OF LP-PANEL BLOCK INSTALLED
GOOD FOR 4 BR CONSIDERING TANK SIZE & LTAR

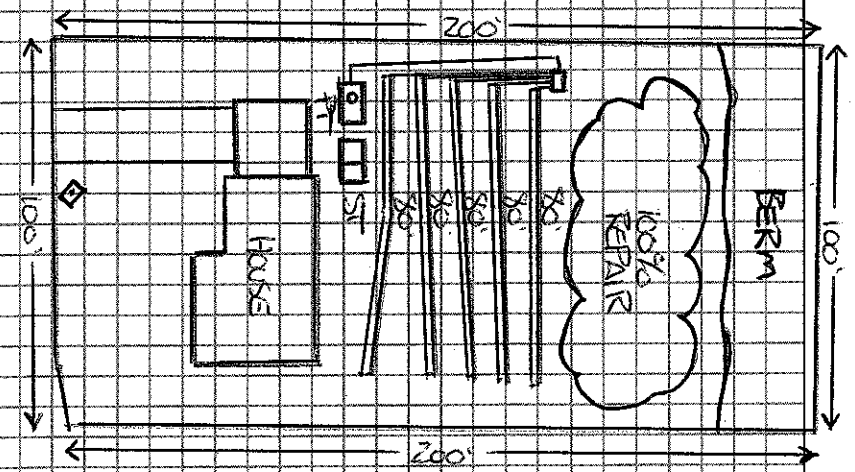

AS BUILT SKETCH

SEWER ALARM BREAKER 39
SEWER PUMP 1, 30

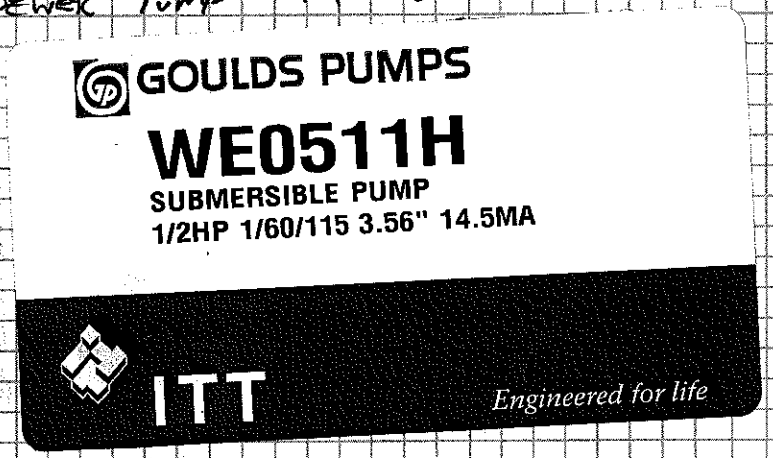

Permit can be suspended or revoked if any false information is supplied toward securing the permit / any unauthorized changes are made to the site / any unauthorized changes are made in the installation of the system.

☐ *IMPROVEMENT PERMIT w / plat valid without expiration.* ☒ *IMPROVEMENT PERMIT w / site plan valid for 60 mos.* ☐ *AUTHORIZATION TO CONSTRUCT valid for period equal to IMPROVEMENT PERMIT-not to exceed 60 mo.*

Owner / Applicant Signature: Date 3/9/10

Improvement Permit by: REHS Date 3-9-10

Authorization to Construct by: REHS Date 3-9-10

Installed by:

Operation Permit by: REHS Date: 5-20-10

Existing System Inspected by: Date:

YOU SHOULD CONTACT A LOCATOR SERVICE PRIOR TO ANY EXCAVATION.

WHITE COPY Environmental Health YELLOW COPY (Final) Owner / Applicant PINK COPY (Initial) Owner / Applicant