10:35

IREDELL COUNTY HEALTH DEPARTMENT

STATESVILLE 704-878-5305 MOORESVILLE 704-664-5281

IMPROVEMENT PERMIT / AUTHORIZATION TO CONSTRUCT / OPERATION PERMIT / EXISTING SYSTEM INSPECTION

PERMIT# 147396 PIN# ~~4761334124.082~~ 4761243517 DATE 2-8-08

OWNER OR APPLICANT Corinthian Builders Ltd PHONE: Business 704-400-1258 Home

ADDRESS P.O. Box 990 Denver NC. 28037

LOCATION Hwy 21 N TR Oswalt Amity TR Wheatfield on left

SUBDIVISION Wheatfield BLOCK / SECTION LOT 82 LOT AREA .52 Ac SITE CLASS. PS DESIGN FLOW 360gpd L.T.A.R. .3gpd/ft²

Septic Tank: 1000 Gallons; STB 786 Date 3-7-13

Pump Tank: 1000 Gallons; PT 32 Date 7-24-12

Pump Make: GOULDS Model WE05IH Serial No.

Nitrification Field: No Fields 1 Square Feet 930 Linear Feet 310

No Lines 4 Trench Width 36" Max Trench Bottom Depth 24"

☒ New System ☐ Repair ☐ Expansion System Type: I II ◍ IV V VI

System Description: 25% reduction pm

Repair System Description: LP PPBPS

Maintenance Agreement Required: ☐ Yes ☒ No

☒ House/Mod. Home No. Bedrooms 3

☐ Mobile Home No. Persons 6

☐ Business No. Employees

☐ Other

Water Supply: ☒ Individual ☐ Public ☐ Community

Gravel Depth NA ☐ Gravity ☒ Pressure ☐ Slab ☒ Crawl Space ☐ Basement w/plumbing ☐ Basement wo/plumbing

Comments:/Conditions:


see pressure manifold details for varying top sizes

Comments:/Conditions:


CHECKED DRAIN FIELD & TANKS & PM 6-6-13 BA

INITIAL SITE SKETCH

See plan from SA EC

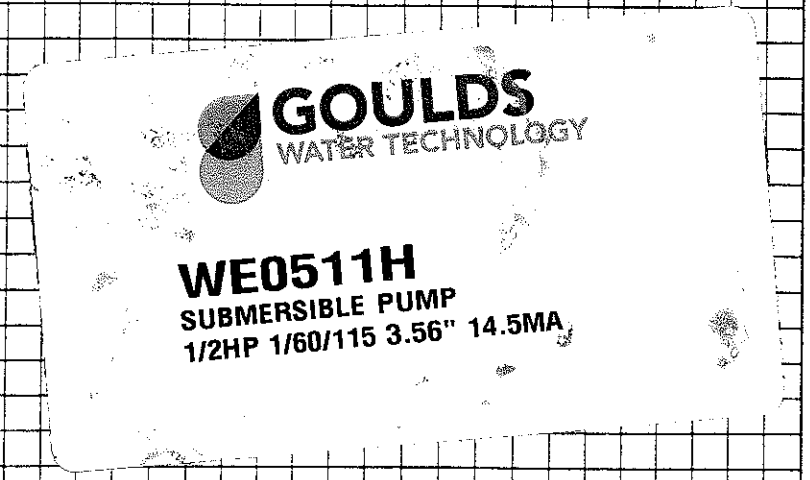

AS BUILT SKETCH

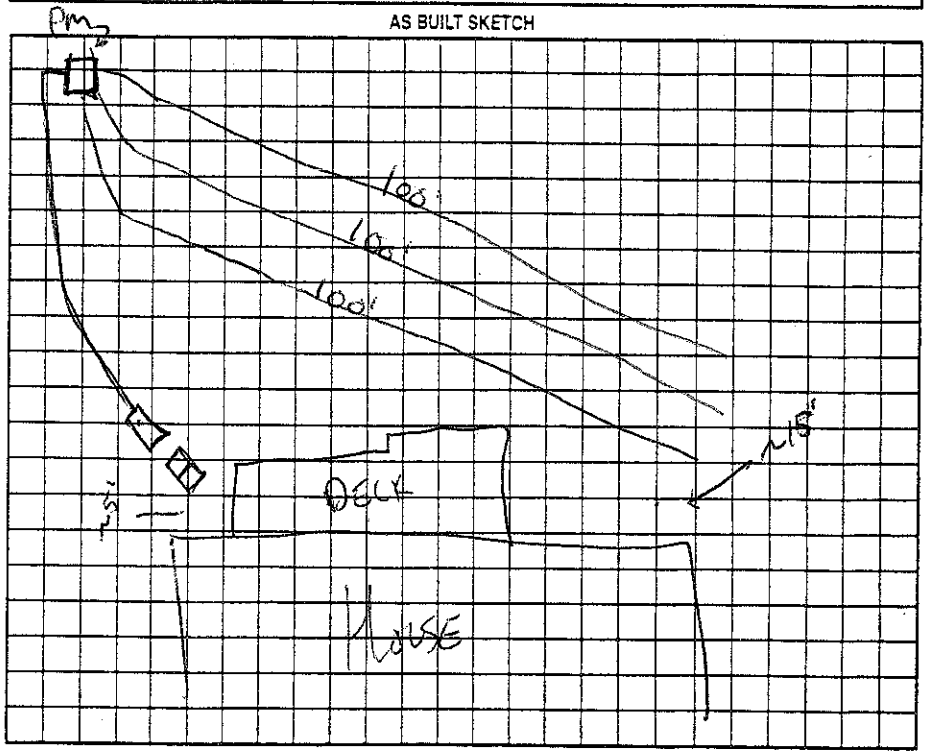

Permit can be suspended or revoked if any false information is supplied toward securing the permit/any unauthorized changes are made to the site/any unauthorized changes are made in the installation of the system. Improvement Permit with plat valid without expiration ☐ Improvement Permit with site plan valid for sixty months ☒ Authorization to Construct is valid for a period equal to that of Improvement Permit – not to exceed sixty months.

Signed: date 3/4/08

Improvement Permit by: date 2-8-08

Authorization to Construct by: date 3-15-13

Installed by: ADAN CLEMENTE RS

Operation Permit by: date 6/19/13

Existing System Inspection by: date

HEALTH DEPT. COPY: WHITE OWNER COPY (FINAL): YELLOW OWNER COPY (INITIAL): PINK