3:00

IREDELL COUNTY HEALTH DEPARTMENT

STATESVILLE 704-878-5305 MOORESVILLE 704-664-5281

IMPROVEMENT PERMIT / AUTHORIZATION TO CONSTRUCT / OPERATION PERMIT / EXISTING SYSTEM INSPECTION

PERMIT # 14744 2 PIN # 4761245492 DATE 9-28-09

OWNER or APPLICANT El Lago LLC PHONE: Business 704 902-7081 Home:

OWNER or APPLICANT ADDRESS P.O. Box 1050 Mooresville, NC 28677

LOCATION / DIRECTIONS Hwy 21 N. TR Oswalt Amity Rd TR Wheatfield TR Emma Mae on right

SUBDIVISION Wheatfield BLOCK / SECTION 5 LOT # 14 LOT AREA .46 Acre DESIGN FLOW 360gpd L.T.A.R. .30

Septic Tank 1000 Gallons: STB 786 Date 7/8/09

Pump Tank ____ Gallons: P.T ____ Date ____

Pump Make ____ Model ____ Serial # ____

Nitrification Field No Fields 1 No Lines 4 Linear Feet 300ft

Trench Width 36" Max. Trench Bottom Depth 36" Gravel Depth N/A

☒ New System ☐ Repair ☐ Expansion System Type I (II) III IV V VI

System Description: Gravity - 25% Reduction

Repair System Description Grav/Pump - 50% Reduction

Maintenance Agreement Required ☐ YES ☒ NO

☒ GRAVITY ☐ PRESSURE

☒ Residence No. Bedrooms 3 ☐ Business No. Persons ____ ☐ Other No. Employees ____


☐ Slab ☒ Crawl Space ☐ Basement w/plumbing ☐ Basement w/o plumbing

Water Supply: ☒ Private ☐ Public ☐ Community

Comments / Conditions ★ Must keep Stormwater runoff from Culvert along PL & prevent any further wash from occurring over Drainfield Initial or Repair. If stormwater ditch > 2ft keep Drainfield 15ft setback.

Comments / Conditions Original site evaluation performed by SAEC (see addendum). Site revisited on 9-24-09 with revised site plan & modifications were made to original plan.

INITIAL SITE SKETCH

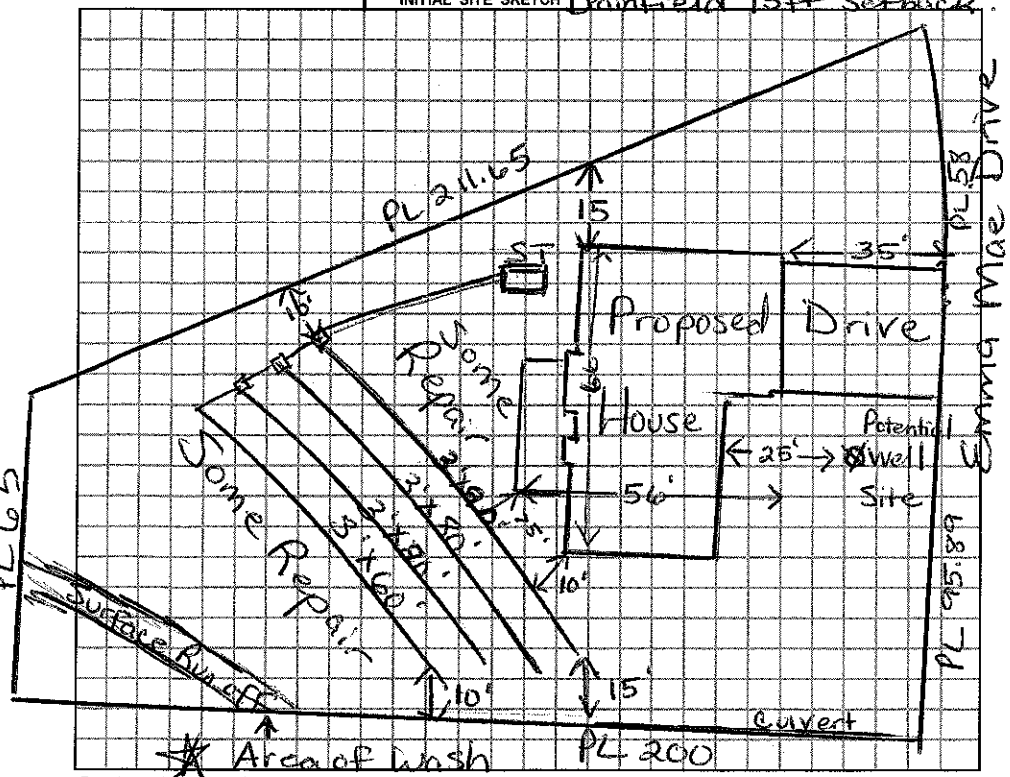

AS BUILT SKETCH

INFILTRATOR Quick 4 INSTALLED

Permit can be suspended or revoked if any false information is supplied toward securing the permit / any unauthorized changes are made to the site / any unauthorized changes are made in the installation of the system.

☐ IMPROVEMENT PERMIT w / plat valid without expiration. ☐ IMPROVEMENT PERMIT w / site plan valid for 60 mos. ☐ AUTHORIZATION TO CONSTRUCT valid for period equal to IMPROVEMENT PERMIT-not to exceed 60 mo.

Owner / Applicant Signature: Victoria Rose Date 9/28/09

Improvement Permit by: Maine H. Dotson RS Date 9/28/09

Authorization to Construct by: Maine H. Dotson RS Date 9/28/09

Installed by: Adam Garcia #3774

Operation Permit by: Wesley Sparks RS. Date: 11/6/09

Existing System Inspected by: ____ Date: ____

YOU SHOULD CONTACT A LOCATOR SERVICE PRIOR TO ANY EXCAVATION.

WHITE COPY Environmental Health YELLOW COPY (Final) Owner / Applicant PINK COPY (Initial) Owner / Applicant