IREDELL COUNTY HEALTH DEPARTMENT

Statesville Office (704) 878-5305 Mooresville Office (704) 660-3625 PERMIT # 201877

IMPROVEMENT PERMIT / AUTHORIZATION TO CONSTRUCT / OPERATION PERMIT / EXISTING SYSTEM

PIN # 4761247948 6868

APPLICANT: BRAZOS DEVELOPMENT APPLICANT ADDRESS: PO BOX 1159 TROUTMAN NC 28166

SITE ADDRESS: 169 WHEATFIELD DR. STATESVILLE NC 28677 PHONE: ALT. PHONE:

SITE DIRECTIONS: OSWALT AMITY - TR WHEATFIELD - ON LT

SUBDIVISION: WHEATFIELD SECTION: 1 LOT # 86 LOT AREA: 1.55 DESIGN FLOW: 360GPD L.T.A.R.: .25

Septic Tank 1000 (gal) STB 786 Date 8-13-13
Pump Tank (gal) PT Date
Pump Make Model Serial # 360
Nitrification Fields 1 # Lines 5 Linear Ft: 360
Trench Width 36" Max. Trench Bottom Depth 36" Gravel Depth N/A

☑ New System ☐ Repair ☐ Expansion System Type: I II III IV V VI
System Description: GRAVITY 25% REDUCTION
Repair System Description: SAME
Maintenance Agreement Required: ☐ YES ☑ NO
☑ GRAVITY ☐ PRESSURE

☑ Residence No. Bedrooms 3
☐ Business No. Persons 6
☐ Other No. Employees
☐ Slab ☑ Crawl Space
☐ Basement w/plumbing ☐ Basement w/o plumbing

Water Supply: ☑ Private ☐ Public ☐ Community

Comments / Conditions:

INITIAL SITE SKETCH

SEE MICHAEL ATHANAS & ASSOCIATES PLAN.

AS BUILT SKETCH

INSTALLED AS DRAWN

Permit can be suspended or revoked if any false information is supplied toward securing the permit / any unauthorized changes are made to the site / any unauthorized changes are made in the installation of the system. **CONTACT A LOCATOR SERVICE PRIOR TO ANY EXCAVATION**

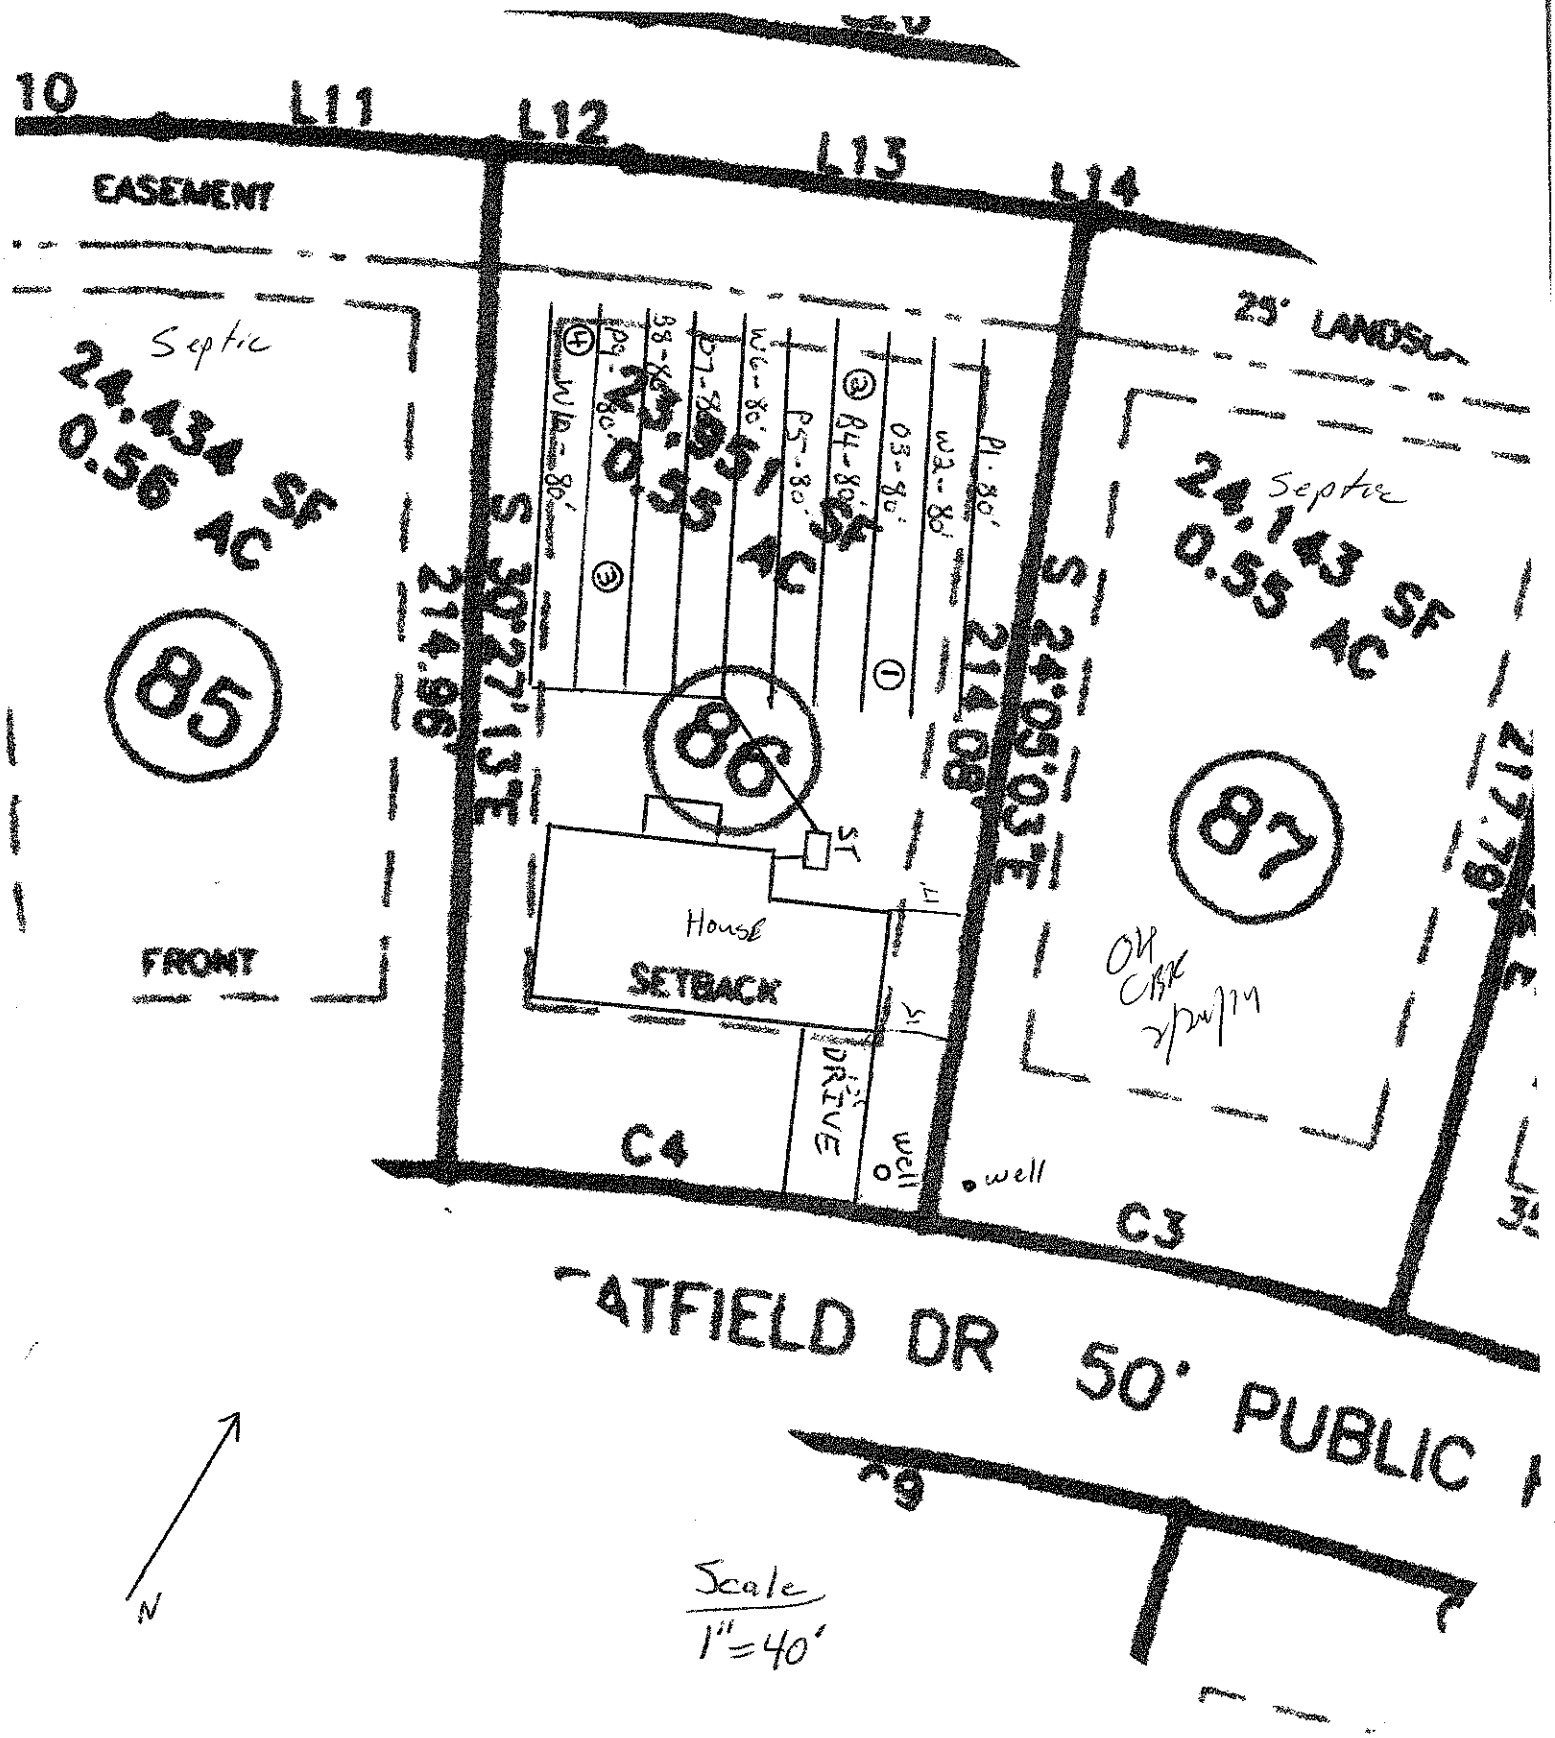
☐ **IMPROVEMENT PERMIT** *with plat valid without expiration.* ☐ **IMPROVEMENT PERMIT** *with site plan valid for 60 mos.* ☐ **AUTHORIZATION TO CONSTRUCT** *valid for period equal to IMPROVEMENT PERMIT--not to exceed 60 mo.*

Owner / Applicant Signature: Date: 2/24/14 Installed by: ADAN CLEMENTE

IMPROVEMENT PERMIT by: REHS Date: 2/24/14 OPERATION PERMIT by: Date: 5-16-14

AUTHORIZATION TO CONSTRUCT by: REHS Date: 2/24/14 Existing System Inspected by: Date:

Health Dept. Copy - WHITE Applicant (Final Approval) - YELLOW Applicant (Conditional Approval) - PINK


10
L11
L12
L13
L14
EASEMENT
25' LANDSC
Septic
24,434 SF
0.56 AC
85
FRONT
S 50°27'15"E
214.96'
86
House
SETBACK
DRIVE
C4
well
S 24°08'03"E
214.88'
87
Septic
24,143 SF
0.55 AC
well
C3
ATFIELD DR 50' PUBLIC
N
Scale
1"=40'