IREDELL COUNTY HEALTH DEPARTMENT - *ENVIRONMENTAL HEALTH* ☐ STATESVILLE OFFICE 704-878-5305 ☒ MOORESVILLE OFFICE 704-664-5281

IMPROVEMENT PERMIT / AUTHORIZATION TO CONSTRUCT / OPERATION PERMIT / EXISTING SYSTEM INSPECTION

PERMIT # 147966 PIN # 4761-24-9628 DATE 11-30-11

OWNER BRAZOS DEVELOPMENT LLC APPLICANT: SAME PHONE: Home/Cell # 704-201-6532 Business #

SITE ADDRESS 176 WHEATFIELD DR. OWNER / APPLICANT ADDRESS SAME

SITE DIRECTIONS OSTWALT AMITTY, WHEATFIELD, ON (R)

SUBDIVISION WHEATFIELD BLOCK / SECTION LOT # 57 LOT AREA .51 AC DESIGN FLOW 360 GAL/DAY L.T.A.R. .25

Septic Tank 1000 Gallons: STB 186 Date 11-1-10

Pump Tank Gallons: P T Date

Pump Make Model Serial #

No. Nitrification Fields: 1 No. Lines 3 Linear Feet 360'

Trench Width 36" Max. Trench Bottom Depth 36" Gravel Depth —

☒ New System ☐ Repair ☐ Expansion System Type I II (III) IV V VI

System Description: G-25%

Repair System Description: SAME

Maintenance Agreement Required ☐ YES ☒ NO

☒ GRAVITY ☐ PRESSURE

☒ Residence No. Bedrooms 3

☐ Business No. Persons

☐ Other No. Employees

☐ Slab ☒ Crawl Space

☐ Basement w/plumbing ☐ Basement w/o plumbing

Water Supply


☒ Private

☐ Public


☐ Community

Comments / Conditions ① INSTALL C EXACTLY 36" DEEP*

INITIAL SITE SKETCH

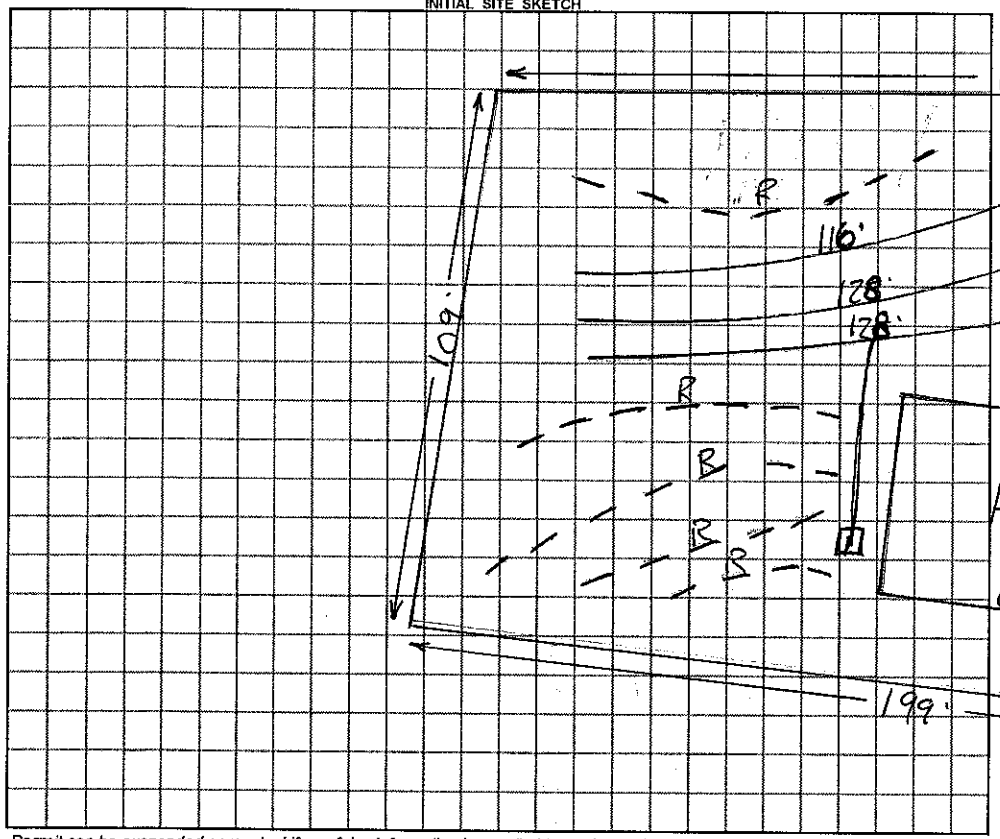

AS BUILT SKETCH

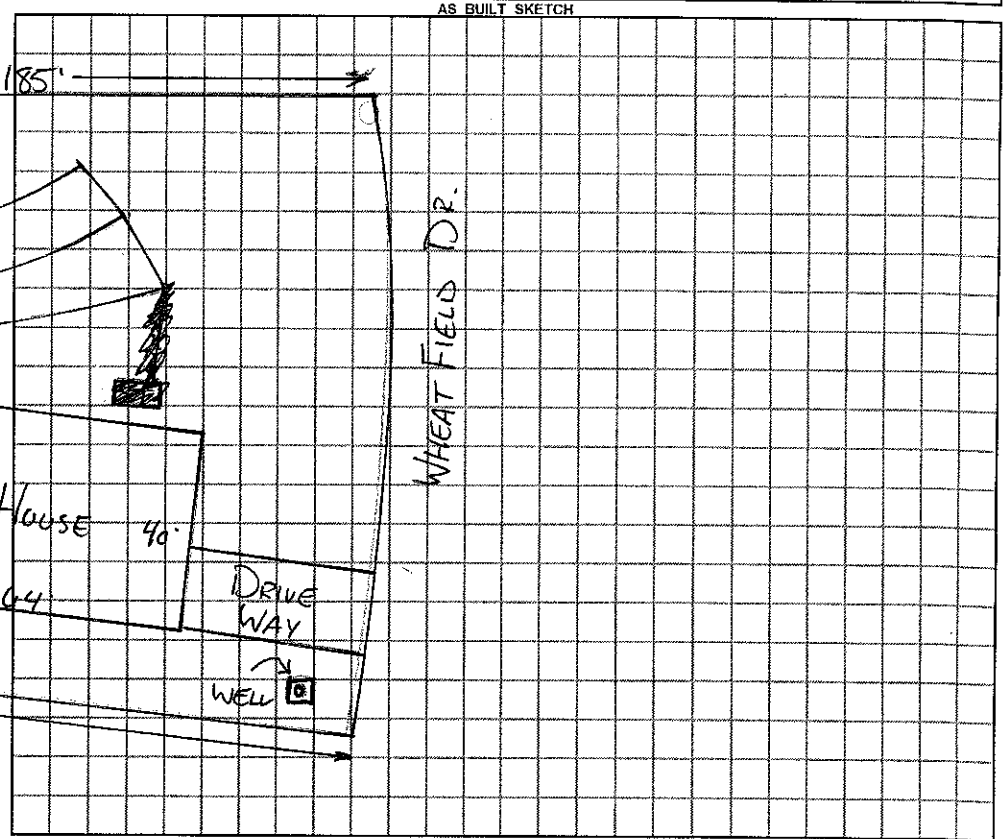

Permit can be suspended or revoked if any false information is supplied toward securing the permit / any unauthorized changes are made to the site / any unauthorized changes are made in the installation of the system.

☐ ***IMPROVEMENT PERMIT*** with plat valid without expiration. ☐ ***IMPROVEMENT PERMIT*** with ~~plat valid without expiration.~~ site plan valid 60 mo. ☒ ***AUTHORIZATION TO CONSTRUCT*** valid for period equal to IMPROVEMENT PERMIT--not to exceed 60 mo.

Owner / Applicant Signature: Date 12-2-11 Installed by:

IMPROVEMENT PERMIT by: REHS Date 11-30-11 OPERATION PERMIT by: REHS Date 1-4-12

AUTHORIZATION TO CONSTRUCT by: REHS Date 11-30-11 Existing System Inspected by: REHS Date

YOU SHOULD CONTACT A LOCATOR SERVICE PRIOR TO ANY EXCAVATION

White Copy – Environmental Health YELLOW COPY (Final) Owner / Applicant PINK COPY (Initial) Owner / Applicant