IREDELL COUNTY HEALTH DEPARTMENT

STATESVILLE 704-878-5305 MOORESVILLE 704-664-5281

IMPROVEMENT PERMIT / CERTIFICATE OF COMPLETION / OPERATION PERMIT / EXISTING SYSTEM INSPECTION

PROPERTY DESCRIPTION NO. 66654 DATE 5-28-97 TAX MAP NO. 4761260574 Watershed: ☐ Yes ☑ No

OWNER OR CONTRACTOR Kimberly Wyatt PHONE: Business Home 528 3320

ADDRESS 894 S Main St Troutman

LOCATION TOE TR Bethesda Rd TR Fieldcrest Dr at ent TR Sutton ct at end left

SUBDIVISION Weishaven BLOCK / SECTION LOT 47A LOT AREA 1 1/4 acres SITE CLASS. PS DESIGN FLOW 360 L.T.A.R. .33

Septic Tank: 1000 Gallons; STB IDR Date 4-22-97
Pump Tank: Gallons; PT Date
Pump Make: Model Serial No.
Nitrification Field: No Fields 1 Square Feet 1080 Linear Feet 360
No Lines 3 Trench Width 36" Max Trench Bottom Depth 36" Gravel Depth 12"


☐ New System ☐ Repair System Type: I, II, III, IV, V, VI
System Description: conv. Gravity
Repair System Description:
Maintenance Agreement Required: ☐ Yes ☐ No

☐ House/Mod. Home No. Bedrooms 3
☑ Mobile Home No. Bathrooms 2
☐ Business No. Employees
☐ Other
☐ Slab ☑ Crawl Space ☐ Basement w/plumbing ☐ Basement wo/plumbing

Water Supply: ☑ Individual ☐ Community ☐ Public


Comments:

INITIAL SITE SKETCH

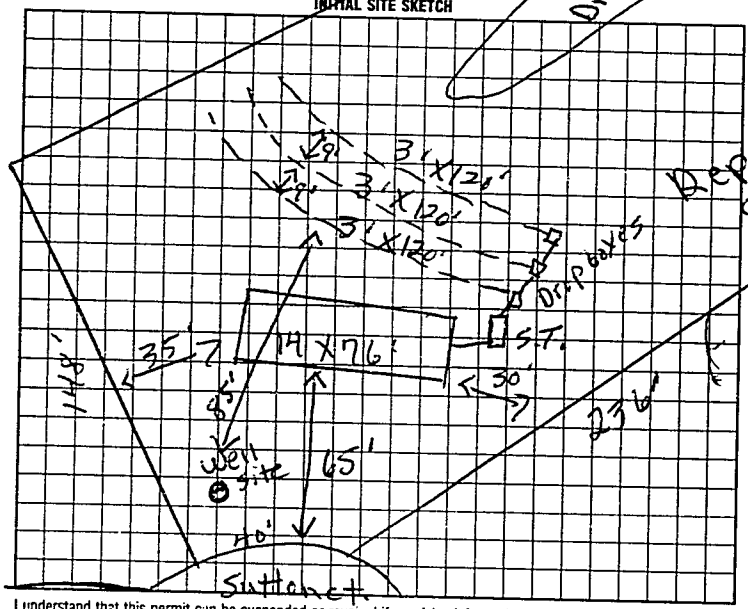

Comments:

AS BUILT SKETCH

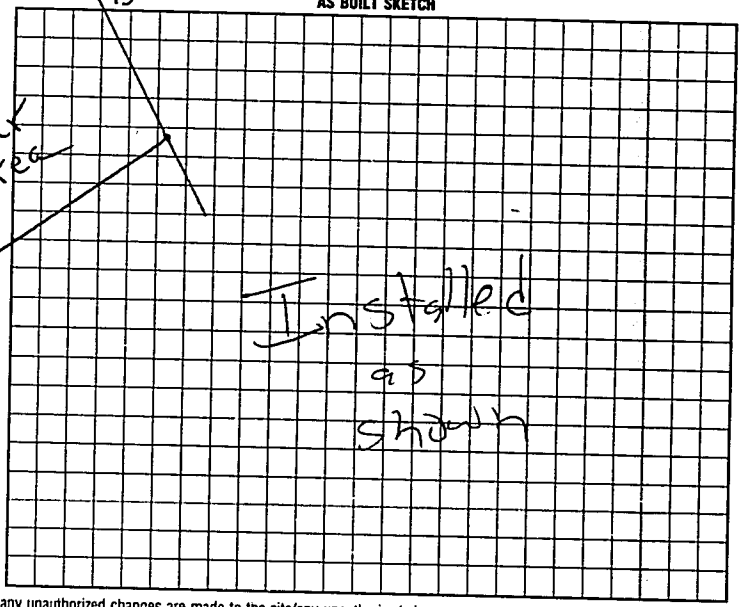

I understand that this permit can be suspended or revoked if any false information is supplied toward securing the permit/any unauthorized changes are made to the site/any unauthorized changes are made in the installation of the system. Improvement Permit is valid for 60 months from date of issuance.

Signed: X Russell Wilson

Improvement Permit by: R. C. Moore date 5-28-97

Existing System Inspection by: R. C. Moore date 5-28-97

Authorization to Cover.

Installed by: A-1 Backhoe

Certificate of Completion by: date

Operation Permit by: Mary C Ortiz date 6-24-97

Authorization to Cover. Expires 60 mos from issue

HEALTH DEPT COPY: WHITE INSPECTION COPY (FINAL): GREEN OWNER COPY (FINAL): YELLOW INSPECTION COPY (INITIAL): PINK OWNER COPY (INITIAL): GOLD

60200