IREDELL COUNTY HEALTH DEPARTMENT

STATESVILLE 704-878-5305 MOORESVILLE 704-664-5281

IMPROVEMENT PERMIT / CERTIFICATE OF COMPLETION / OPERATION PERMIT / EXISTING SYSTEM INSPECTION

PROPERTY DESCRIPTION NO. 69657 DATE 7-14-97 TAX MAP NO. 4761260574 Watershed: ☐ Yes ☑ No

OWNER OR CONTRACTOR Integrity Homes PHONE: Business _____ Home _____

ADDRESS 894 S. Main St. Troutman N.C.

LOCATION 70E TR Bethesda TR Fieldcrest on left before Sutton Ct.

SUBDIVISION Woodhaven BLOCK / SECTION _____ LOT 47B LOT AREA 1.10 acres SITE CLASS. PS DESIGN FLOW ~~360~~ 300 L.T.A.R. .35

Septic Tank: 1000 Gallons; STB 1012 Date 7-21-97

Pump Tank: _____ Gallons; PT _____ Date _____

Pump Make: _____ Model _____ Serial No. _____

Nitrification Field: No Fields 1 Square Feet 1380 Linear Feet 460

No Lines 4 Trench Width 36" Max Trench Bottom Depth 36" Gravel Depth 12"

☑ New System ☐ Repair System Type: I, ☑ II, III, IV, V, VI

System Description: Conv. Gravity

Repair System Description: " "

Maintenance Agreement Required: ☐ Yes ☑ No

☐ House/Mod. Home ☑ Mobile Home ☐ Business ☐ Other

No. Bedrooms 4 No. Bathrooms 3 No. Employees _____


☐ Slab ☑ Crawl Space ☐ Basement w/plumbing ☐ Basement wo/plumbing

Water Supply: ☑ Individual ☐ Community ☐ Public


Comments:

Comments: System sized for 3 Bedrooms

INITIAL SITE SKETCH

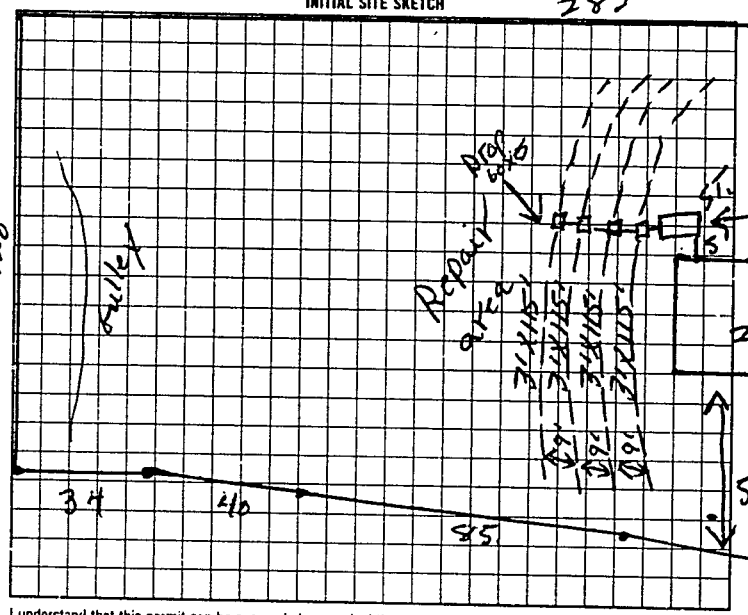

AS BUILT SKETCH

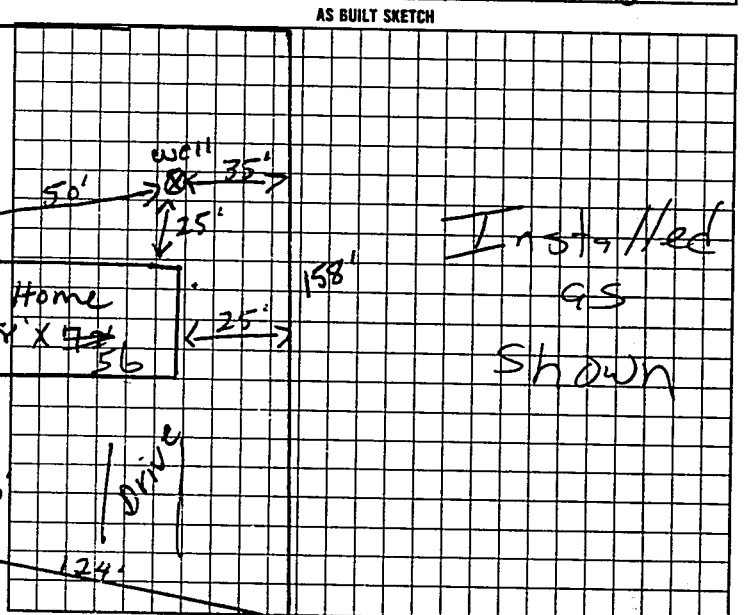

I understand that this permit can be suspended or revoked if any false information is supplied toward securing the permit/any unauthorized changes are made to the site/any unauthorized changes are made in the installation of the system. Improvement Permit is valid for 60 months from date of issuance.

Signed: _____

Improvement Permit by: R. C. Moore date 7-14-97

Authorization to Construct by: R. C. Moore date 7-14-97

Installed by: A-1 Backhoe

Certificate of Completion by: _____ date _____

Operation Permit by: Mary C. Ott RS date 8-10-97

Authorization to Construct. Expires 60 days from issue

HEALTH DEPT COPY WHITE INSPECTION COPY (FINAL) GREEN OWNER COPY (FINAL) YELLOW INSPECTION COPY (INITIAL) PINK OWNER COPY (INITIAL) GOLD

00132