IREDELL COUNTY HEALTH DEPARTMENT

STATESVILLE 704-878-5305 MOORESVILLE 704-664-5281

IMPROVEMENT PERMIT / AUTHORIZATION TO CONSTRUCT / OPERATION PERMIT / EXISTING SYSTEM INSPECTION

PERMIT# 86406 PIN# 4761264893 DATE 11-30-99

OWNER OR CONTRACTOR James C. Allen PHONE, Business Statesville Home 528 0285

ADDRESS 196 Fieldcrest Dr.

LOCATION 70 E TR Bethesda Rd TR Fieldcrest 1/4 mi Rt.

SUBDIVISION ____ BLOCK / SECTION ____ LOT ____ LOT AREA 2.0 acres SITE CLASS PS DESIGN FLOW 240 L.T.A.R. .33

Septic Tank: 1000 Gallons: STB 160 Date 11-2-99
Pump Tank: ____ Gallons: PT ____ Date ____
Pump Make: ____ Model ____ Serial No. ____
Nitrification Field: No Fields 1 Square Feet 720 Linear Feet 240
No Lines 4 Trench Width 36" Max Trench Bottom Depth 36" Gravel Depth 12"

☑ New System ☐ Repair System Type: I (II) III, IV, V, VI
System Description: Conv. Gravity
Repair System Description: Pump To Conv.
Maintenance Agreement Required: ☐ Yes ☑ No


☐ House/Mod. Home No. Bedrooms 2
☑ Mobile Home No. Bathrooms 1
☐ Business No. Employees ____
☐ Other ____
☐ Slab ☐ Crawl Space ☐ Basement w/plumbing ☐ Basement wo/plumbing

Water Supply: ☑ Individual ☐ Public ☐ Community


Comments/Conditions:

Comments/Conditions:

INITIAL SITE SKETCH

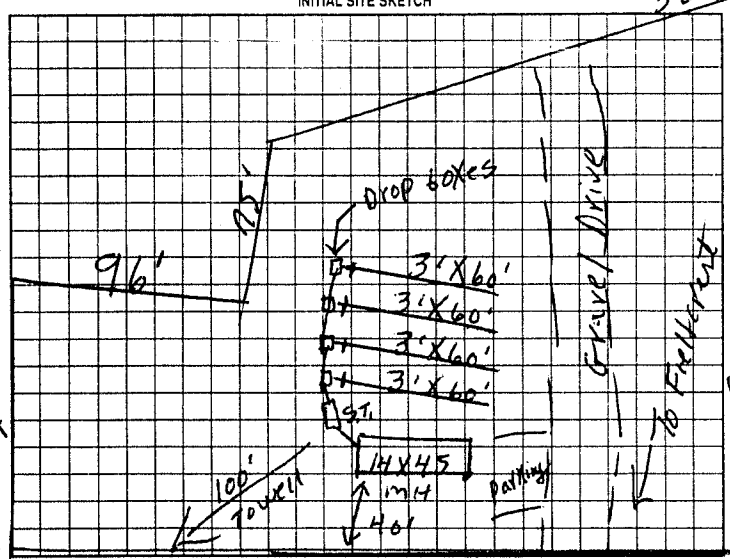

AS BUILT SKETCH

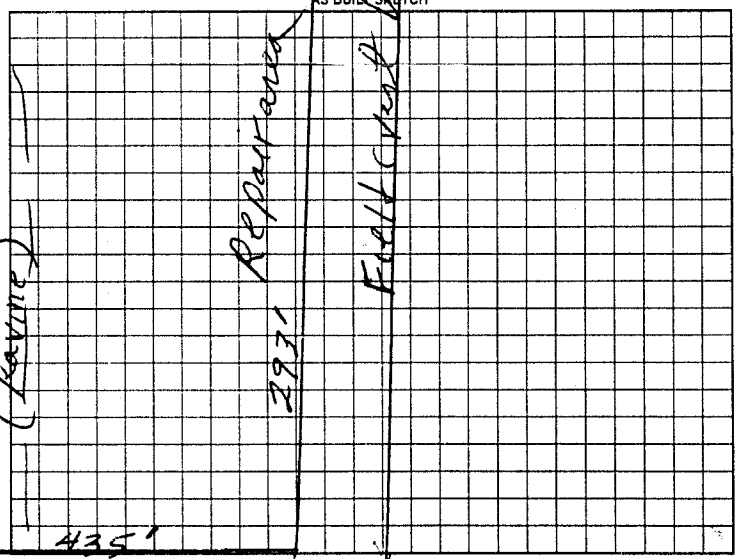

Permit can be suspended or revoked if any false information is supplied toward securing the permit/any unauthorized changes are made to the site/any unauthorized changes are made in the installation of the system. Improvement Permit with plat valid without expiration. Improvement Permit with site plan valid for sixty months. Authorization to Construct is valid for a period equal to that of Improvement Permit – not to exceed sixty months.

Signed: X James C. Allen date ____ Installed by: Barry Simmons

Improvement Permit by: R. C. Moore date 11-30-99 Operation Permit by: R. C. Moore date 1-04-00

Authorization to Construct by: R. C. Moore date 11-30-99 Existing System Inspection by: ____ date ____

HEALTH DEPT. COPY: WHITE OWNER COPY (FINAL): YELLOW OWNER COPY (INITIAL): PINK