IREDELL COUNTY HEALTH DEPARTMENT

STATESVILLE 704-878-5305 (C1) MOORESVILLE 704-664-5281

IMPROVEMENT PERMIT / AUTHORIZATION TO CONSTRUCT / OPERATION PERMIT / EXISTING SYSTEM INSPECTION

PERMIT# 122303 PIN# 4760-26-7489 4761-26-5237 DATE 7-23-04

OWNER OR CONTRACTOR LUV HOMES of TROUTMAN PHONE: Business 704-528-0848 Home

ADDRESS 1036 CHARLOTTE HWY, TROUTMAN, NC 28116

LOCATION US 70 EAST, TR BETHESDA ROAD, TR FIELDCREST DRIVE, LOT #48 ON LEFT

SUBDIVISION WOODHAVEN BLOCK / SECTION LOT 48 LOT AREA 1.0 ± SITE CLASS. PS DESIGN FLOW 360 L.T.A.R. 0.30 GPD/FT²

Septic Tank: 1000 Gallons; STB 1012 Date 3-26-04

Pump Tank: Gallons; PT Date

Pump Make: Model Serial No.

Nitrification Field: No Fields 1 Square Feet EQ-TO 1200 Linear Feet 200

No Lines FOUR Trench Width 24" Max Trench Bottom Depth 36" ~~Gravel~~ Depth SAND 24"

☑ New System ☐ Repair System Type: I, II, III, IV, V, VI

System Description: 50% REDUCTION GRAVITY

Repair System Description: 50% REDUCTION, LOW-PRESSURE

Maintenance Agreement Required: ☐ Yes ☒ No

☐ House/Mod. Home No. Bedrooms 3

☒ Mobile Home No. Bathrooms 2

☐ Business No. Employees

☐ Other


☐ Slab ☑ Crawl Space ☐ Basement w/plumbing ☐ Basement wo/plumbing

Water Supply: ☑ Individual ☐ Public ☐ Community WELL NEXT DOOR


Comments/Conditions: INSTALL 50% REDUCTION SYSTEM AS SHOWN ON CONTOUR USING 48 PPBPS PANELS. USE ONE EFFLUENT SPLITTER TO ACHIEVE EQUAL DISTRIBUTION INTO EACH LINE.

Comments/Conditions: SEPTIC TANK WITH MARKER INSTALLED USING "TUFTITE" FILTER

INITIAL SITE SKETCH

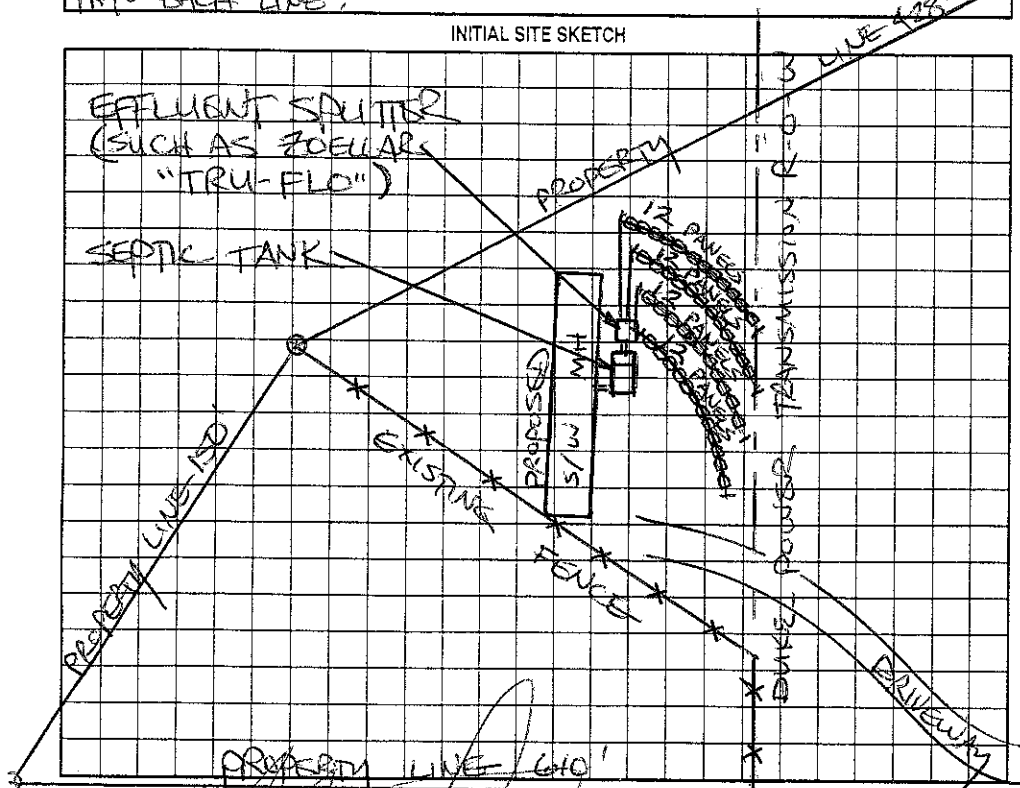

AS BUILT SKETCH

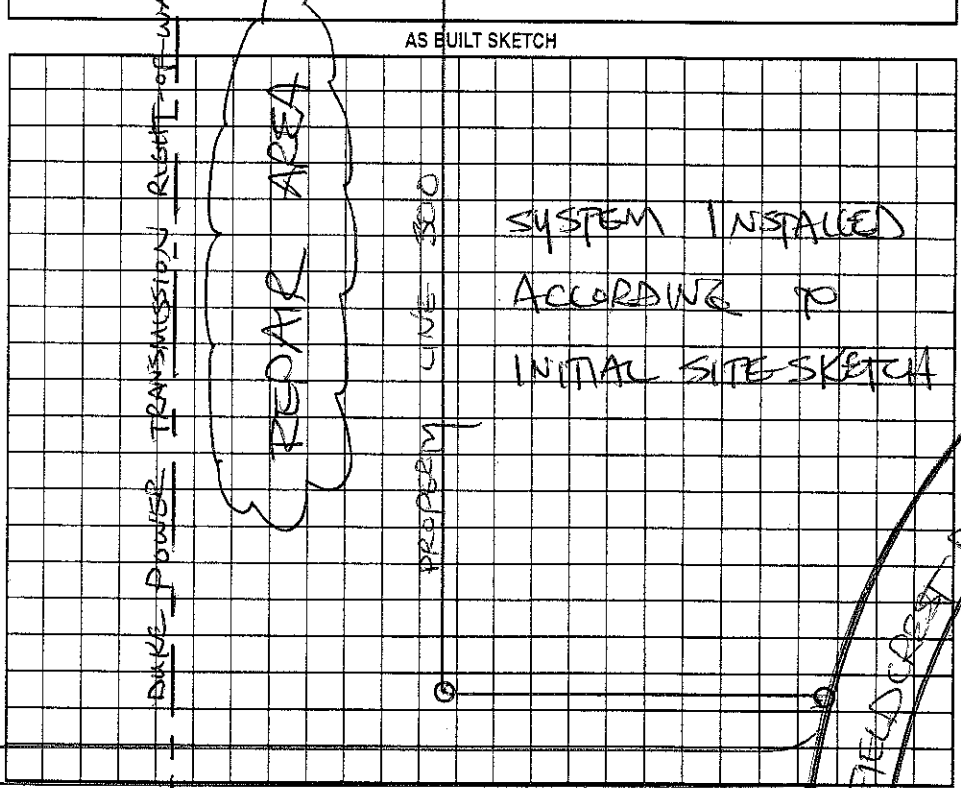

Permit can be suspended or revoked if any false information is supplied toward securing the permit/any unauthorized changes are made to the site/any unauthorized changes are made in the installation of the system. Improvement Permit with plat valid without expiration. Improvement Permit with site plan valid for sixty months. Authorization to Construct is valid for a period equal to that of Improvement Permit – not to exceed sixty months.

Signed: date 7/26/04 Installed by: CRAIG THOMPSON

Improvement Permit by: STEVE HEDRICK date 7-23-04 Operation Permit by: STEVE HEDRICK date 8-19-04

Authorization to Construct by: STEVE HEDRICK date 7-23-04 Existing System Inspection by: date

HEALTH DEPT. COPY: WHITE OWNER COPY (FINAL): YELLOW OWNER COPY (INITIAL): PINK