IREDELL COUNTY HEALTH DEPARTMENT

STATESVILLE 704-878-5305 MOORESVILLE 704-664-5281

IMPROVEMENT PERMIT / AUTHORIZATION TO CONSTRUCT / OPERATION PERMIT / EXISTING SYSTEM INSPECTION

PERMIT# 81431 PIN# 4761283306 DATE 7-19-99

OWNER OR CONTRACTOR Robert Moul PHONE: Business _____ Home 660 8352

ADDRESS 315 Talbert Rd Mooresville

LOCATION Amity Hill Tb Bethania Tb Reuben Tb Jeremy 1/4mi left

SUBDIVISION Beechwood BLOCK / SECTION 2 LOT 26 LOT AREA 1.32 acres SITE CLASS PS DESIGN FLOW 360 L.T.A.R. .3

Septic Tank: 1000 Gallons; STB 825 Date _____

Pump Tank: _____ Gallons; PT _____ Date _____

Pump Make: _____ Model _____ Serial No. _____

Nitrification Field: No Fields 1 Square Feet 900 Linear Feet 300

No Lines 4 Trench Width 36" Max Trench Bottom Depth 36" Gravel Depth N/A

☑ New System ☐ Repair System Type: I. II. III. IV. V.

System Description: Gravity 2570 Rebut.

Repair System Description: _____

Maintenance Agreement Required: ☐ Yes ☑ No

☐ House/Mod. Home ☑ Mobile Home ☐ Business ☐ Other

No. Bedrooms 3 No. Bathrooms 2 No. Employees _____

☐ Slab ☑ Crawl Space ☐ Basement w/plumbing ☐ Basement wo/plumbing


Water Supply: ☑ Individual ☐ Public ☐ Community

Comments/Conditions:


555'

Comments/Conditions no 20 System Installed & Covered in wet weather

INITIAL SITE SKETCH

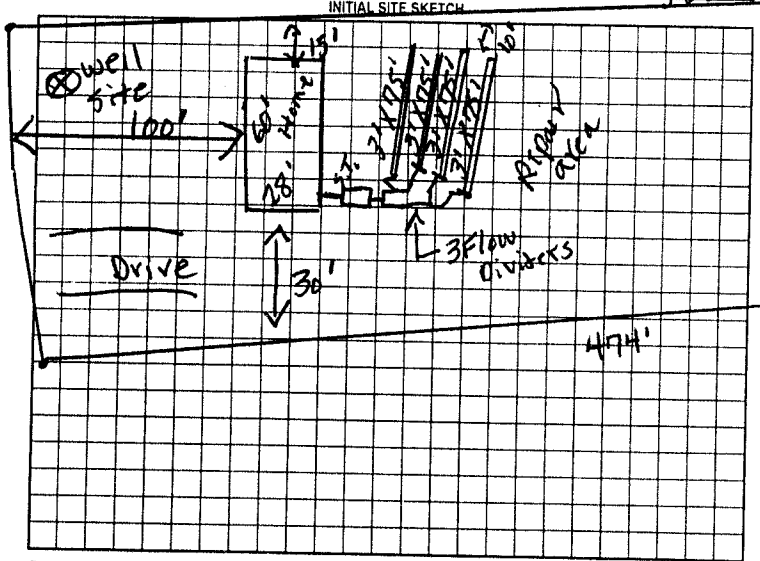

AS BUILT SKETCH

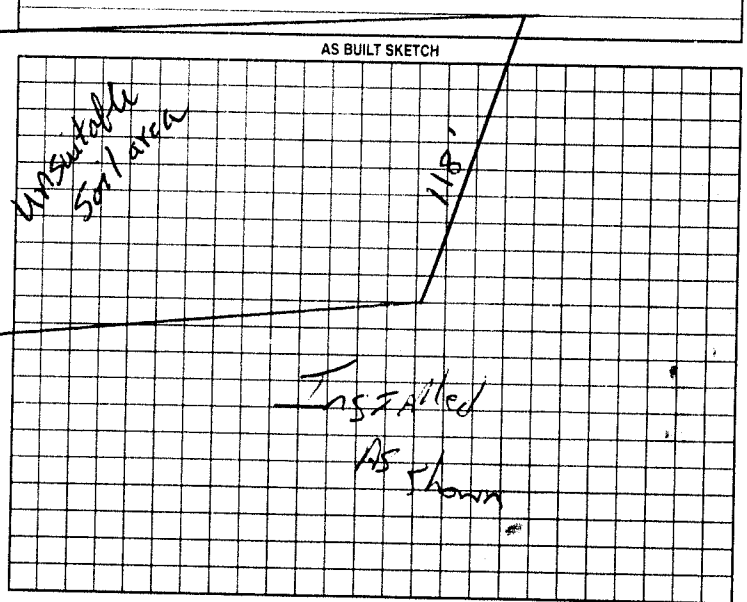

Permit can be suspended or revoked if any false information is supplied toward securing the permit/any unauthorized changes are made to the site/any unauthorized changes are made in the installation of the system. Improvement Permit with plat valid without expiration. Improvement Permit with site plan valid for sixty months. Authorization to Construct is valid for a period equal to that of Improvement Permit – not to exceed sixty months.

Signed: Carlena Moul date _____

Improvement Permit by: P. C. Moore date 7-19-99

Authorization to Construct by: P. C. Moore date 7-19-99

Installed by: JST Ent Thompson

Operation Permit by: for Letter date Oct 20, 99

Existing System Inspection by: _____ date _____

HEALTH DEPT. COPY WHITE OWNER COPY (FINAL) YELLOW OWNER COPY (INITIAL) PINK