IREDELL COUNTY HEALTH DEPARTMENT

STATESVILLE 704-878-5305 MOORESVILLE 704-664-5281

50670

IMPROVEMENT PERMIT / CERTIFICATE OF COMPLETION / OPERATION PERMIT / EXISTING SYSTEM INSPECTION

PROPERTY DESCRIPTION NO. 17777 DATE 2-10-94 TAX MAP NO. 5B-3-A-25 Watershed: ☐ Yes ☐ No

OWNER OR CONTRACTOR Darrell Atkins PHONE: Business Home 664-5896

ADDRESS Rt 1 Box 219-A Troutman, N.C.

LOCATION 70E TR Bethesda TR Reuben Dr. TL Jeremy Ln 1/4mi on Lft

SUBDIVISION Beechwood BLOCK / SECTION II LOT LOT AREA 1 Acres SITE CLASS. 25 DESIGN FLOW 360 L.T.A.R. .3

Septic Tank: 1000 Gallons; STB 358 Date 3-9-94

Pump Tank: Gallons; PT Date

Pump Make: Model Serial No.

Nitrification Field: No Fields 1 Square Feet 1200 Linear Feet 400

No Lines 5 Trench Width 36 Max Trench Bottom Depth 24" Gravel Depth 12

☑ New System ☐ Repair System Type: I, II, III, IV, V, VI

System Description: conv Gravity

Repair System Description:

Maintenance Agreement Required: ☐ Yes ☐ No

☐ House/Mod. Home ☑ Mobile Home ☐ Business ☐ Other

No. Bedrooms 3 No. Bathrooms 2 No. Employees


☐ Slab ☑ Crawl Space ☐ Basement w/plumbing ☐ Basement wo/plumbing

Water Supply: ☑ Individual ☐ Community ☐ Public


Comments: Keep lines shallow no deeper than 24"

Comments: System was originally installed Too Deep Then was Filled In with Extra Stone to proper depth

INITIAL SITE SKETCH

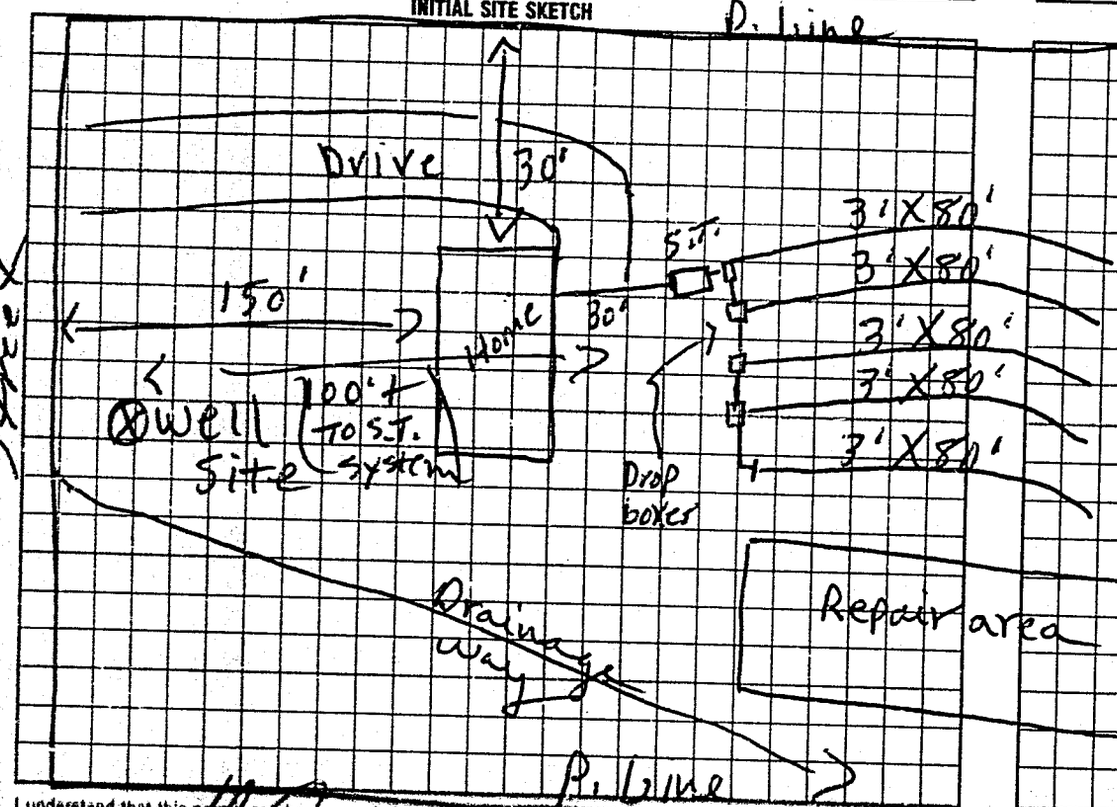

AS BUILT SKETCH

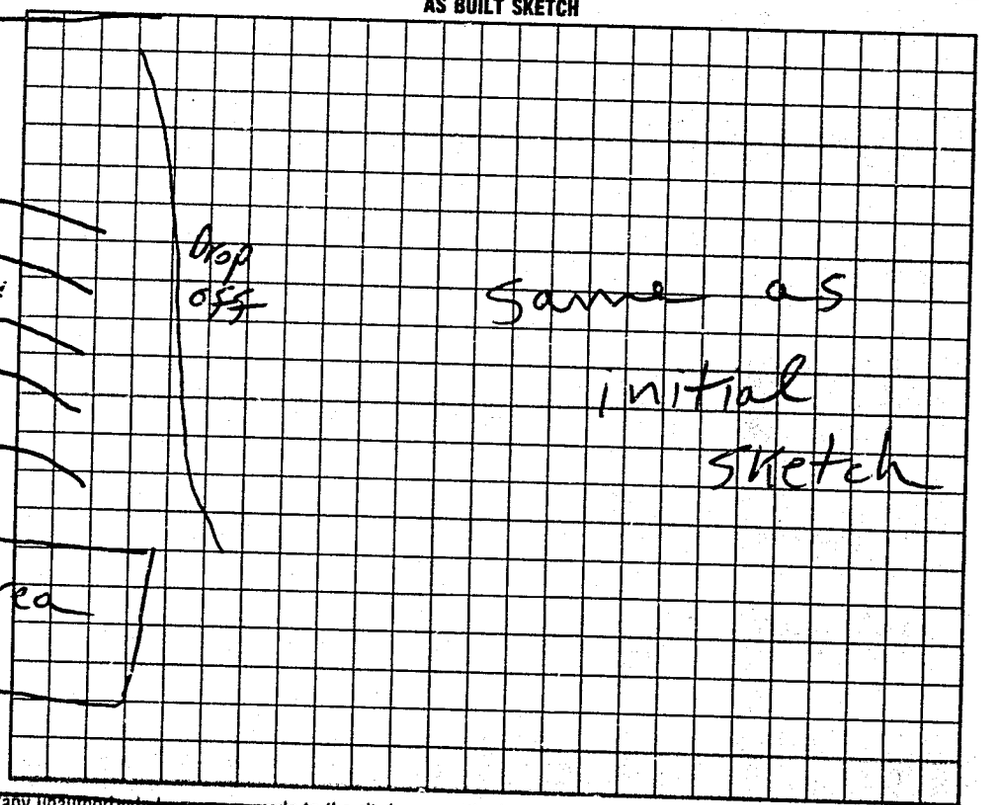

I understand that this permit can be suspended or revoked if any false information is supplied toward securing the permit/any unauthorized changes are made to the site/any unauthorized changes are made in the installation of the system. Improvement Permit is valid for 60 months from date of issuance.

Signed: X

Improvement Permit by: R. C. Moore date 2-10-94

Existing System Inspection by: date

Installed by: Clyde Young

Certificate of Completion by: R. C. Moore date 5-3-94

Operation Permit by: date

HEALTH DEPT. COPY WHITE INSPECTION COPY (FINAL) GREEN OWNER COPY (FINAL) YELLOW INSPECTION COPY (INITIAL) PINK OWNER COPY (INITIAL) GOLD