11:30 61856

IREDELL COUNTY HEALTH DEPARTMENT

STATESVILLE 704-878-5305 MOORESVILLE 704-664-5281

IMPROVEMENT PERMIT / CERTIFICATE OF COMPLETION / OPERATION PERMIT / EXISTING SYSTEM INSPECTION

PROPERTY DESCRIPTION NO. 20086 DATE 1-30-96 TAX MAP NO. 5B-3-A-45 Watershed: ☐ Yes ☒ No

OWNER OR CONTRACTOR SCOTT D. BEATTIE PHONE: Business Home 528-9913

ADDRESS RT-1, BOX 259-A TROUTMAN, NC 28166

LOCATION US 70 E, TR BETHESDA RD, TR REUBEN, TL JEREMY LANE, 3RD LOT ON (R) PAST ASHLEY COURT

SUBDIVISION BEECHWOOD BLOCK / SECTION II LOT 45 LOT AREA 125'x26'x100'x222' SITE CLASS. P3 DESIGN FLOW 360 L.T.A.R. 0.30 GPD/FT²

Septic Tank: 1000 Gallons; STB 821 Date 6-13-96

Pump Tank: Gallons; PT Date

Pump Make: Model Serial No.

Nitrification Field: No Fields 1 Square Feet 1200 Linear Feet 400

No Lines 5 Trench Width 36" Max Trench Bottom Depth 18-36" Gravel Depth 12"

☐ New System ☐ Repair System Type: I, (II), III, IV, V, VI

System Description: CONVENTIONAL GRAVITY

Repair System Description: CHAMBERED GRAVITY

Maintenance Agreement Required: ☐ Yes ☒ No

☐ House/Mod. Home ☒ Mobile Home ☐ Business ☐ Other

No. Bedrooms 3 No. Bathrooms 2 No. Employees


☐ Slab ☒ Crawl Space ☐ Basement w/plumbing ☐ Basement wo/plumbing

Water Supply: ☒ Individual ☐ Community ☐ Public WELL


Comments: ① KEEP SYSTEM 100' FROM WELL, 10' FROM PROPERTY LINE 5' FROM MH ② INSTALL LINES ON CONTOUR USING SERIAL DISTRIBUTION, NO DEEPER THAN 36", 9' MINIMUM APART ON CENTERS.

Comments: well & mh not on site at time of this inspection

INITIAL SITE SKETCH

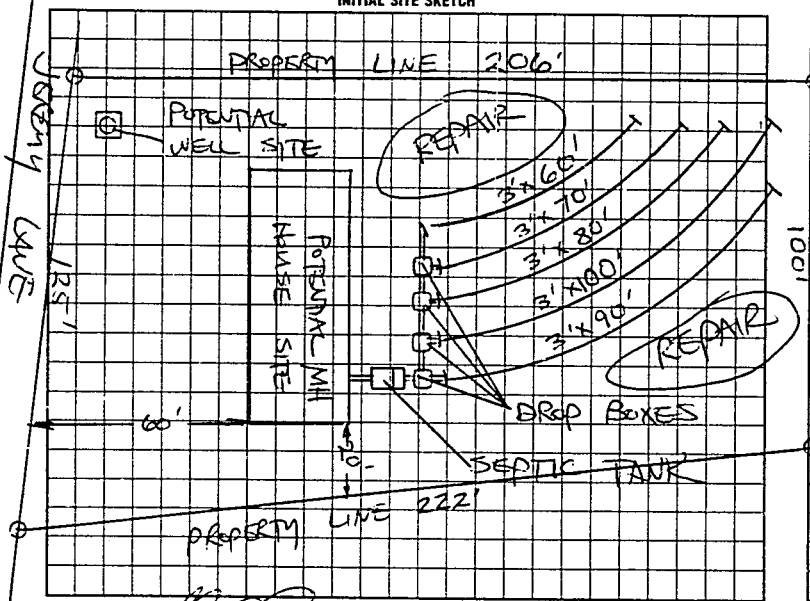

AS BUILT SKETCH

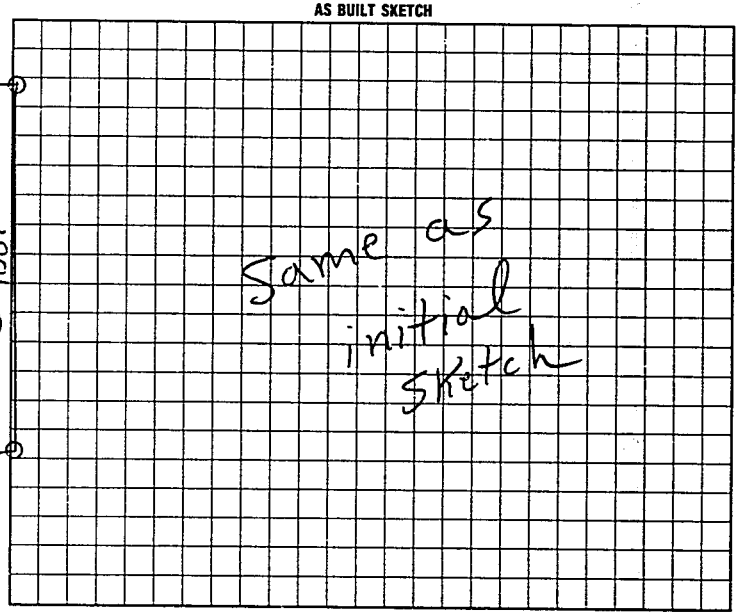

I understand that this permit can be suspended or revoked if any false information is supplied toward securing the permit/any unauthorized changes are made to the site/any unauthorized changes are made in the installation of the system. AUTHORIZATION TO CONSTRUCT IS VALID FIVE (5) YEARS FROM DATE OF ISSUANCE. IMPROVEMENT PERMIT HAS NO EXPIRATION DATE.

Signed:

Improvement Permit by: STEVE HEDRICK date 1-30-96

AUTHORIZATION TO CONSTRUCT ~~Existing System Inspection~~ by: STEVE HEDRICK date 4-12-96

Installed by: GEM Enterprizes

~~Certificate of Completion by:~~ date

Operation Permit by: R.C. Moore date 7-16-96

HEALTH DEPT. COPY: WHITE INSPECTION COPY (FINAL): GREEN OWNER COPY (FINAL): YELLOW INSPECTION COPY (INITIAL): PINK OWNER COPY (INITIAL): GOLD

8800248