IREDELL COUNTY HEALTH DEPARTMENT

STATESVILLE 704-878-5305 MOORESVILLE 704-664-5281

IMPROVEMENT PERMIT / CERTIFICATE OF COMPLETION / OPERATION PERMIT / EXISTING SYSTEM INSPECTION

PROPERTY DESCRIPTION NO. 20087 DATE 1-24-95 TAX MAP NO. 56-3-A-46 Watershed: ☐ Yes ☑ No

OWNER OR CONTRACTOR Scott Beattie PHONE: Business Home

ADDRESS Rt 1 Box 259-A Troutman, N.C.

LOCATION Hwy 70 E TR Bethesda TR Reuben OR TL Jeremy Lin 2nd lot on Rt Past Ashley Ct.

SUBDIVISION Beechwood BLOCK / SECTION II LOT 46 LOT AREA 1.629 acres SITE CLASS. PS DESIGN FLOW L.T.A.R.

Septic Tank: 1000 Gallons; STB 821 Date 7-21-95

Pump Tank: Gallons; PT Date

Pump Make: Model Serial No.

Nitrification Field: No Fields 1 Square Feet 1200 Linear Feet 400

No Lines 4 Trench Width 36" Max Trench Bottom Depth 36" Gravel Depth 12"

☑ New System ☐ Repair System Type: I, II, III, IV, V, VI

System Description: Conv. Gravity

Repair System Description: Porus Block Panel

Maintenance Agreement Required: ☐ Yes ☑ No

☐ House/Mod. Home ☑ Mobile Home ☐ Business ☐ Other

No. Bedrooms 3 No. Bathrooms 2 No. Employees


☐ Slab ☑ Crawl Space ☐ Basement w/plumbing ☐ Basement wo/plumbing

Water Supply: ☐ Individual ☐ Community ☐ Public


Comments:

Comments: Well + mobile NOT on site at Time of This inspection Keep Proper distances from S.T. System as shown on sketch

INITIAL SITE SKETCH

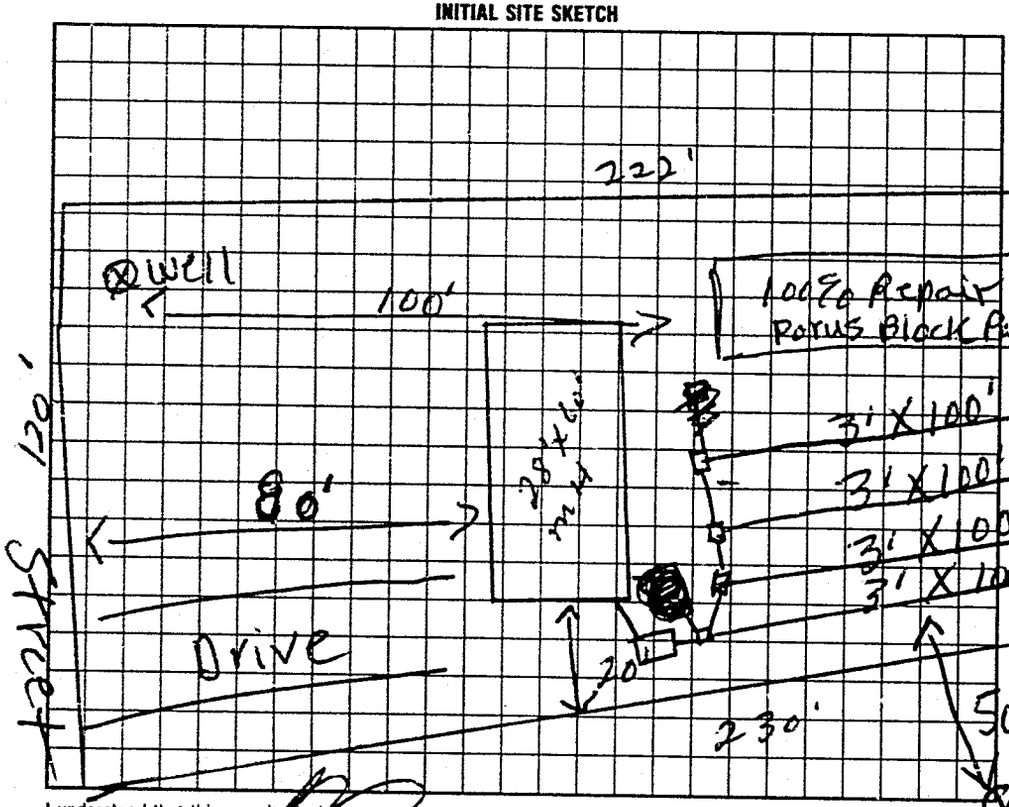

AS BUILT SKETCH

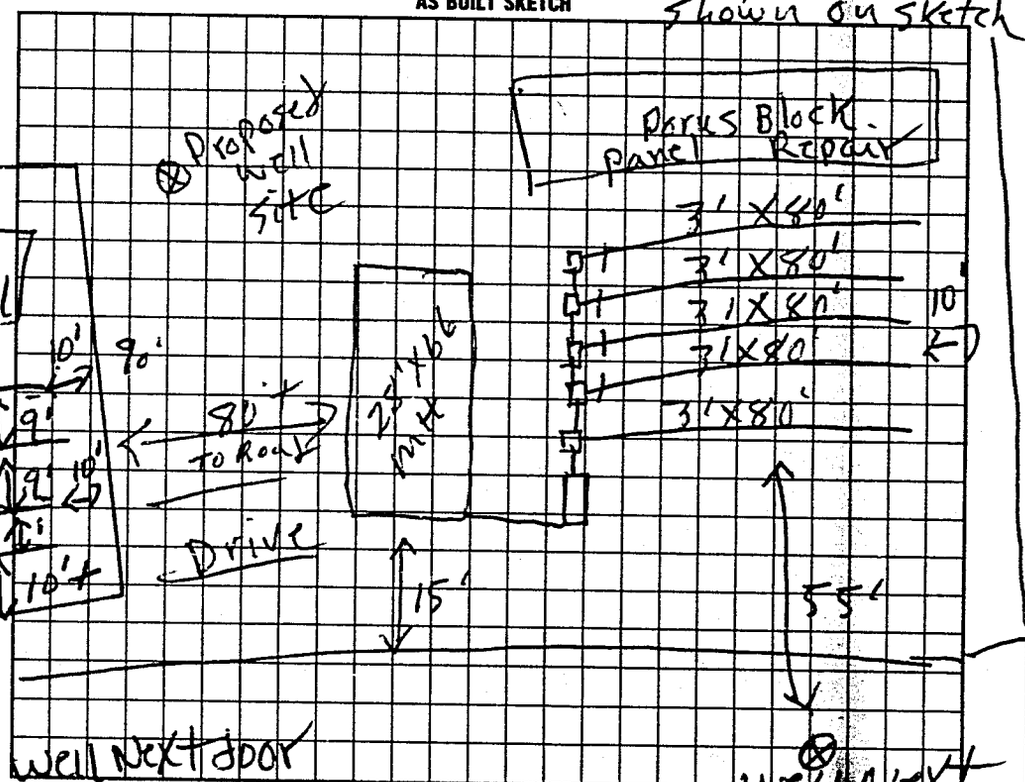

I understand that this permit can be suspended or revoked if any false information is supplied toward securing the permit/any unauthorized changes are made to the site/any unauthorized changes are made in the installation of the system. Improvement Permit is valid for 60 months from date of issuance.

Signed:

Improvement Permit by: J.C. Moore date 1-24-95

Existing System Inspection by: date

Installed by: G & M Enterprizes

Certificate of Completion by: J.C. Moore date 8-25-95

Operation Permit by: date

HEALTH DEPT. COPY: WHITE INSPECTION COPY (FINAL): GREEN OWNER COPY (FINAL): YELLOW INSPECTION COPY (INITIAL): PINK OWNER COPY (INITIAL): GOLD

9 5 0 2 1 1