IREDELL COUNTY HEALTH DEPARTMENT

STATESVILLE 704-878-5305 MOORESVILLE 704-664-5281

IMPROVEMENT PERMIT / AUTHORIZATION TO CONSTRUCT / OPERATION PERMIT / EXISTING SYSTEM INSPECTION

PERMIT# 98010 PIN# 4761 28 8466 DATE 3-15-00

OWNER OR CONTRACTOR Keith Hollenbeck PHONE: Business Home 663-6394

ADDRESS 776-401 White Oaks Rd Mooresville

LOCATION 70 E TR Bethesda TR Reuben TL Jeremy 8th lot on left.

SUBDIVISION Beechwood BLOCK / SECTION II LOT 22 LOT AREA 2.91 acres SITE CLASS 1 PS DESIGN FLOW 360 L.T.A.R. .13

Septic Tank: 1000 Gallons; STB 825 Date 4 3 00

Pump Tank: Gallons; PT Date

Pump Make: Model Serial No.

Nitrification Field: No Fields 1 Square Feet 900 Linear Feet 300

No Lines 3 Trench Width 36" Max Trench Bottom Depth 36" Gravel Depth N/A

☑ New System ☐ Repair System Type: I, II, III, IV, V, VI

System Description: Gravity 25% Red.

Repair System Description:

Maintenance Agreement Required: ☐ Yes ☑ No

☐ Slab ☐ Crawl Space ☐ Basement w/plumbing ☐ Basement wo/plumbing

☐ House/Mod. Home No. Bedrooms 3

☑ Mobile Home No. Bathrooms 2

☐ Business No. Employees

☐ Other


Water Supply: ☑ Individual ☐ Public ☐ Community

Comments/Conditions:


Comments/Conditions

System installed as Designed w/ 50 Ch. Amberg's

INITIAL SITE SKETCH

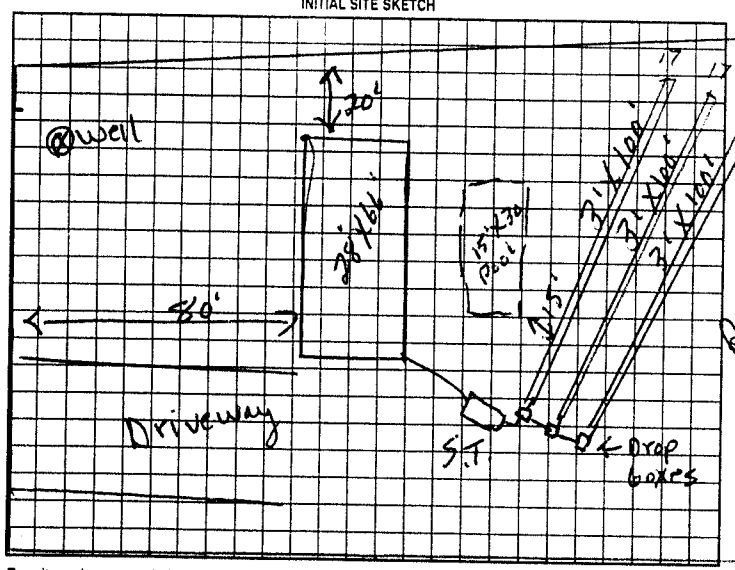

AS BUILT SKETCH

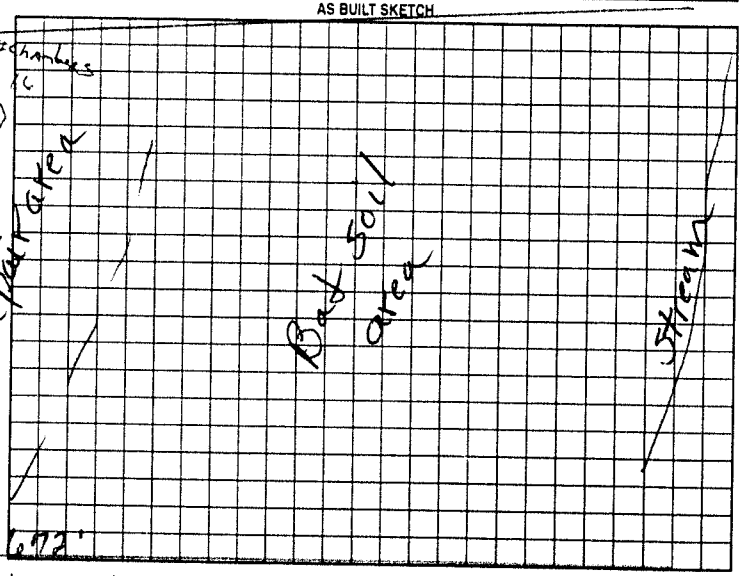

Permit can be suspended or revoked if any false information is supplied toward securing the permit/any unauthorized changes are made to the site/any unauthorized changes are made in the installation of the system. Improvement Permit with plat valid without expiration. Improvement Permit with site plan valid for sixty months. Authorization to Construct is valid for a period equal to that of Improvement Permit – not to exceed sixty months.

Signed: Kathy Boggs date 3-28-00

Improvement Permit by: F. C. Moore date 3-15-00

Authorization to Construct by: F. C. Moore date 3-15-00

Installed by: Upright Grading

Operation Permit by: date June 1-2000

Existing System Inspection by: date

HEALTH DEPT. COPY: WHITE OWNER COPY (FINAL): YELLOW OWNER COPY (INITIAL): PINK