IREDELL COUNTY HEALTH DEPARTMENT

STATESVILLE 704-878-5305 MOORESVILLE 704-664-5281

IMPROVEMENT PERMIT / CERTIFICATE OF COMPLETION / OPERATION PERMIT / EXISTING SYSTEM INSPECTION

PROPERTY DESCRIPTION NO. 19140 DATE 7-29-94 TAX MAP NO. 5B-3-A-21 Watershed: ☐ Yes ☑ No

OWNER OR CONTRACTOR Phillip Bowles PHONE: Business Home 663-2220

ADDRESS 223 Whitesmill Rd

LOCATION 70 E TR Bethesta 3mi TR Ruben Dr, TL Jeromy

SUBDIVISION Beechwood BLOCK / SECTION II LOT 21 LOT AREA 1 acre SITE CLASS. PS DESIGN FLOW 360 L.T.A.R. .35

Septic Tank: 1000 Gallons; STB 5-22-94 Date

Pump Tank: Gallons; PT 1012 Date

Pump Make: Model Serial No.

Nitrification Field: No Fields Square Feet Linear Feet

No Lines Trench Width Max Trench Bottom Depth Gravel Depth

☑ New System ☐ Repair System Type: I, II, III, IV, V, VI

System Description: Conv. Gravity

Repair System Description: " "

Maintenance Agreement Required: ☐ Yes ☐ No

☐ Slab ☐ Crawl Space ☐ Basement w/plumbing ☐ Basement wo/plumbing

☐ House/Mod. Home No. Bedrooms 3

☑ Mobile Home No. Bathrooms 2

☐ Business No. Employees


☐ Other

Water Supply: ☑ Individual ☐ Community ☐ Public


Comments: Keep system 10' off property lines

Comments: Well & mH Not located at time of this inspection keep proper distances from S.T. system Not Enough Area left for Conv. Repair will have

INITIAL SITE SKETCH

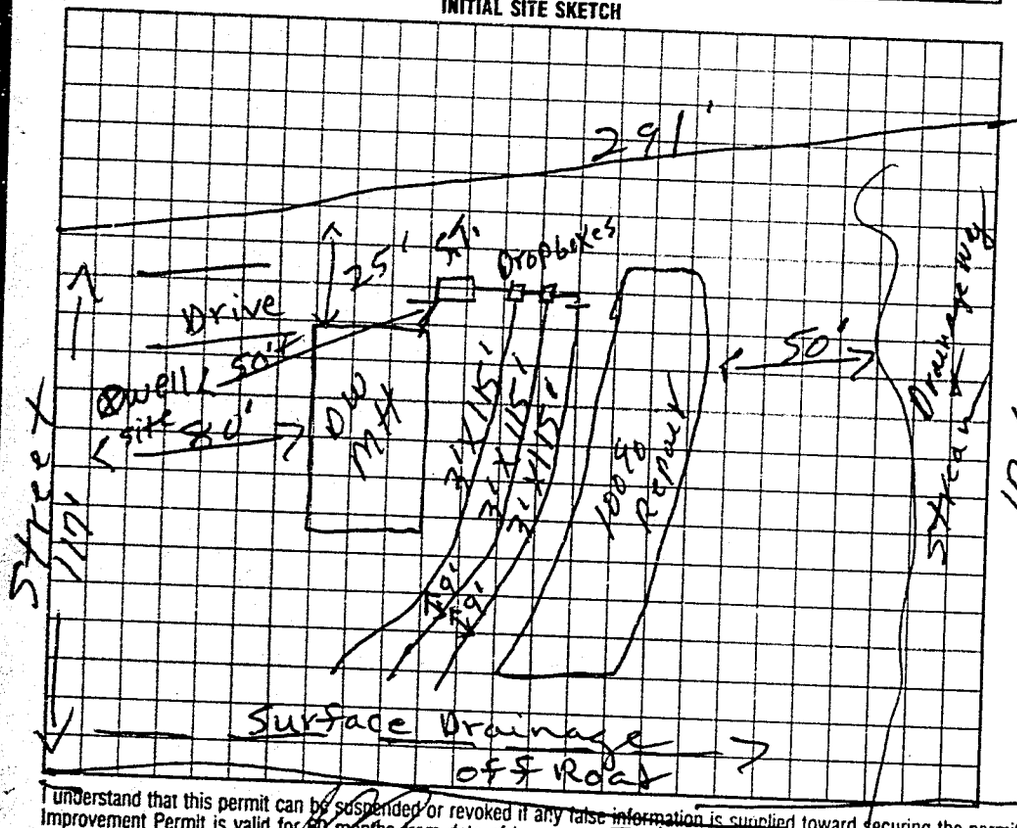

AS BUILT SKETCH

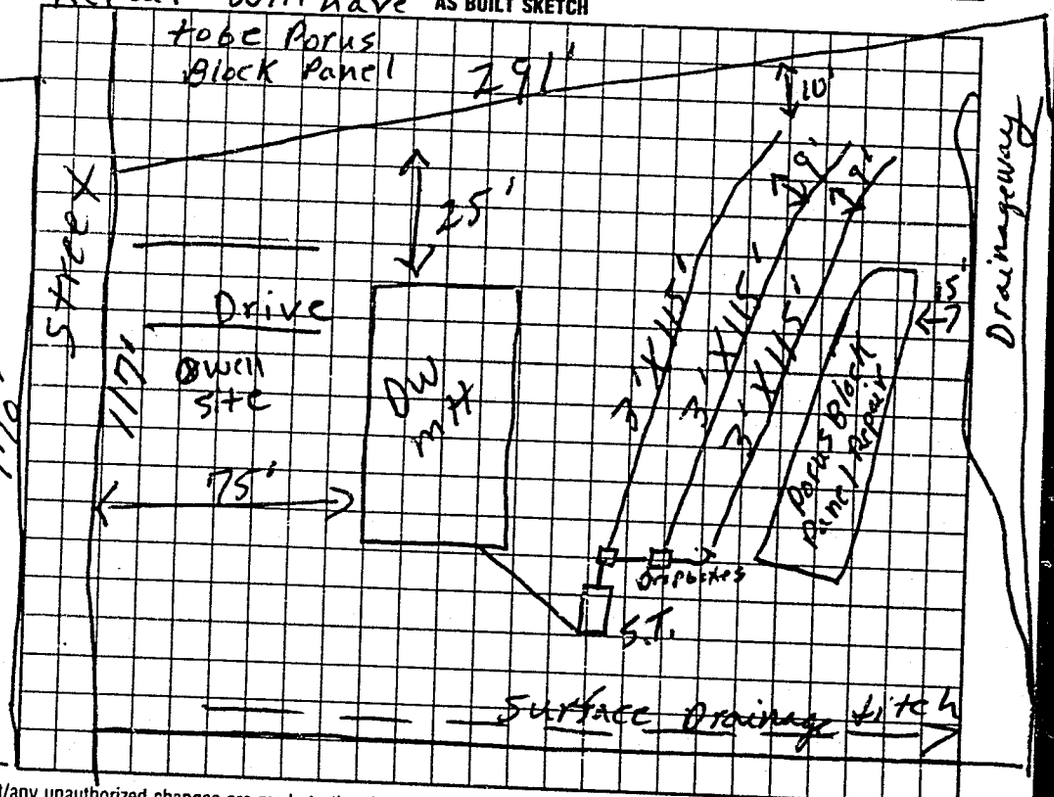

I understand that this permit can be suspended or revoked if any false information is supplied toward securing the permit/any unauthorized changes are made to the site/any unauthorized changes are made in the installation of the system. Improvement Permit is valid for 60 months from date of issuance. 349'

Signed:

Improvement Permit by: P. C. Moore date 7-29-94

Existing System Inspection by: date

Installed by: Kenny Pearson

Certificate of Completion by: P. C. Moore date 8-26-94

Operation Permit by: date

HEALTH DEPT. COPY: WHITE INSPECTION COPY (FINAL): GREEN OWNER COPY (FINAL): YELLOW INSPECTION COPY (INITIAL): PINK OWNER COPY (INITIAL): GOLD