56096

IREDELL COUNTY HEALTH DEPARTMENT

STATESVILLE 704-878-5305 MOORESVILLE 704-664-5281

IMPROVEMENT PERMIT / CERTIFICATE OF COMPLETION / OPERATION PERMIT / EXISTING SYSTEM INSPECTION

PROPERTY DESCRIPTION NO. 20092 DATE 1-20-95 TAX MAP NO. 5B-3-A-16 Watershed: ☐ Yes ☑ No

OWNER OR CONTRACTOR Scott Beattie PHONE: Business _____ Home _____

ADDRESS RT 1 Box 259-A Trout Man

LOCATION Hwy 70 E TR B-Theta Rd TR Reuben Lane 9th lot left

SUBDIVISION Beechwood BLOCK / SECTION II LOT 76 LOT AREA 1.481 acres SITE CLASS. P3 DESIGN FLOW 360 L.T.A.R. 1.3

Septic Tank: 1000 Gallons; STB 521 Date 7-20-95

Pump Tank: _____ Gallons; PT _____ Date _____

Pump Make: _____ Model _____ Serial No. _____

Nitrification Field: No Fields 1 Square Feet 1200 Linear Feet 400

No Lines 6 Trench Width 36" Max Trench Bottom Depth 36" Gravel Depth 12"

☑ New System ☐ Repair System Type: I, II, III, IV, V, VI

System Description: Conv. Gravity

Repair System Description: Porus Block Panel

Maintenance Agreement Required: ☐ Yes ☐ No

☐ House/Mod. Home ☑ Mobile Home ☐ Business ☐ Other

No. Bedrooms 3 No. Bathrooms 2 No. Employees _____


☐ Slab ☑ Crawl Space ☐ Basement w/plumbing ☐ Basement wo/plumbing

Water Supply: ☑ Individual ☐ Community ☐ Public


Comments:

Comments: locate Home at least 5' off S.T. system. The Home was not on site at time of this inspection

INITIAL SITE SKETCH 1421

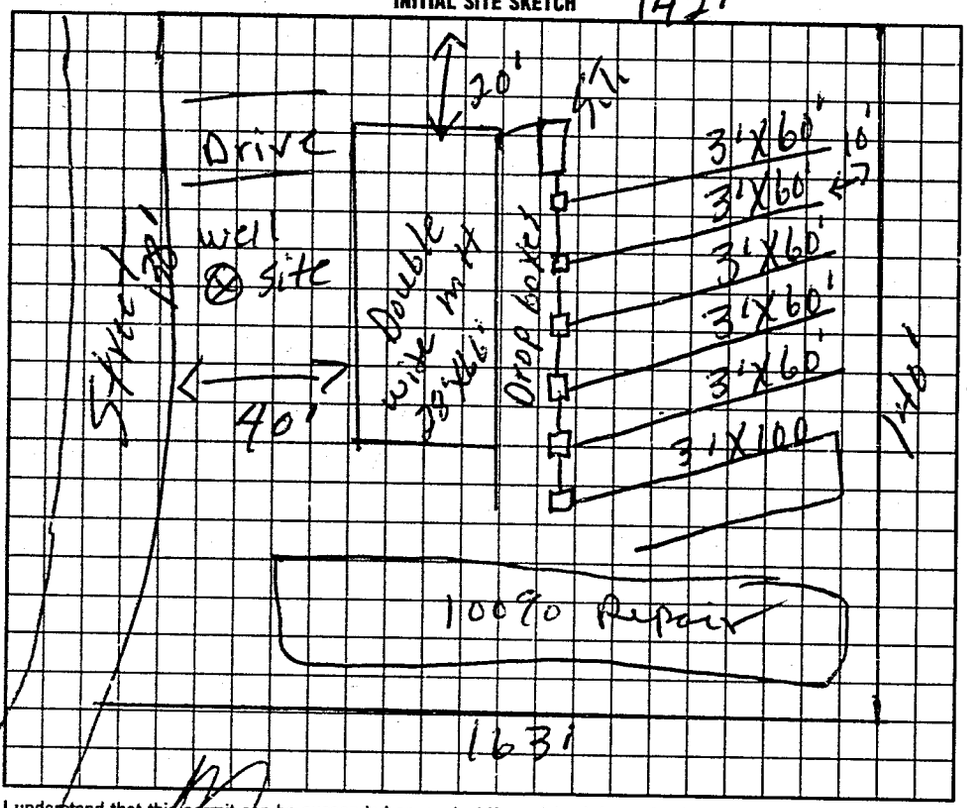

AS BUILT SKETCH

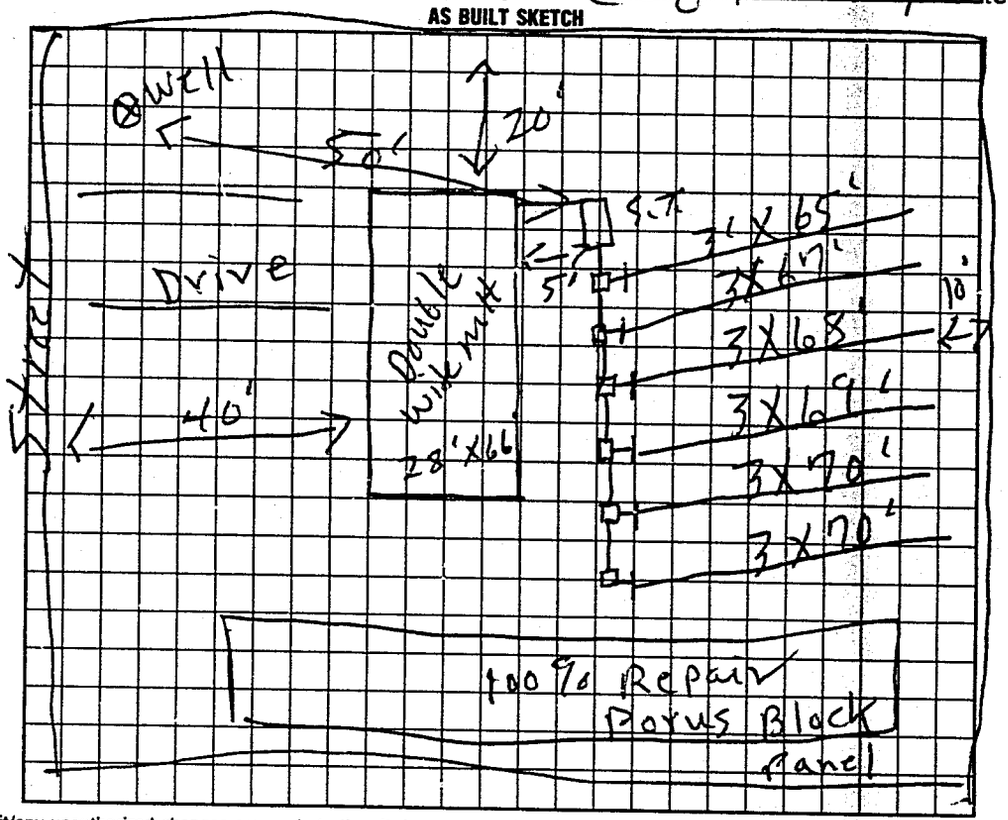

I understand that this permit can be suspended or revoked if any false information is supplied toward securing the permit/any unauthorized changes are made to the site/any unauthorized changes are made in the installation of the system. Improvement Permit is valid for 60 months from date of issuance.

Signed: _____

Improvement Permit by: P.C. Moore date 1-20-95

Existing System Inspection by: _____ date _____

Installed by: G E M Enterprizes

Certificate of Completion by: J.C. Moore date 8-25-95

Operation Permit by: _____ date _____

HEALTH DEPT. COPY: WHITE INSPECTION COPY (FINAL): GREEN OWNER COPY (FINAL): YELLOW INSPECTION COPY (INITIAL): PINK OWNER COPY (INITIAL): GOLD