IREDELL COUNTY HEALTH DEPARTMENT

Water Computer

STATESVILLE 704-878-5305 MOORESVILLE 704-664-5281

IMPROVEMENT PERMIT / CERTIFICATE OF COMPLETION / OPERATION PERMIT / EXISTING SYSTEM INSPECTION

PROPERTY DESCRIPTION NO. 18466 DATE 5-11-94 TAX MAP NO. 5B3-A-67 Watershed: ☐ Yes ☑ No

OWNER OR CONTRACTOR Evie Huffman PHONE: Business _____ Home 663-7797

ADDRESS Rt 11 Box 353 Mooresville

LOCATION 70E TR Bethesda TR Ruben Dr. 1/4 mi on Rt

SUBDIVISION Beechwood BLOCK / SECTION II LOT 67 LOT AREA 1.03 acres SITE CLASS. D5 DESIGN FLOW 360 L.T.A.R. .35

Septic Tank: 1000 Gallons; STB _____ Date _____

Pump Tank: _____ Gallons; PT _____ Date _____

Pump Make: _____ Model _____ Serial No. 350

Nitrification Field: No Fields 1 Square Feet 1055 Linear Feet ~~355~~

No Lines 3 Trench Width 36" Max Trench Bottom Depth 36" Gravel Depth 12"

☑ New System ☐ Repair System Type: I, (II), III, IV, V, VI

System Description: Conv. Gravity IL LL

Repair System Description: _____

Maintenance Agreement Required: ☐ Yes ☐ No

☐ House/Mod. Home No. Bedrooms 3

☑ Mobile Home No. Bathrooms 2

☐ Business No. Employees _____

☐ Other _____


☐ Slab ☑ Crawl Space ☐ Basement w/plumbing ☐ Basement wo/plumbing

Water Supply: ☑ Individual ☐ Community ☐ Public


Comments:

Comments: well & mh not located at time of this inspection. Keep proper distances from S.T. system

INITIAL SITE SKETCH

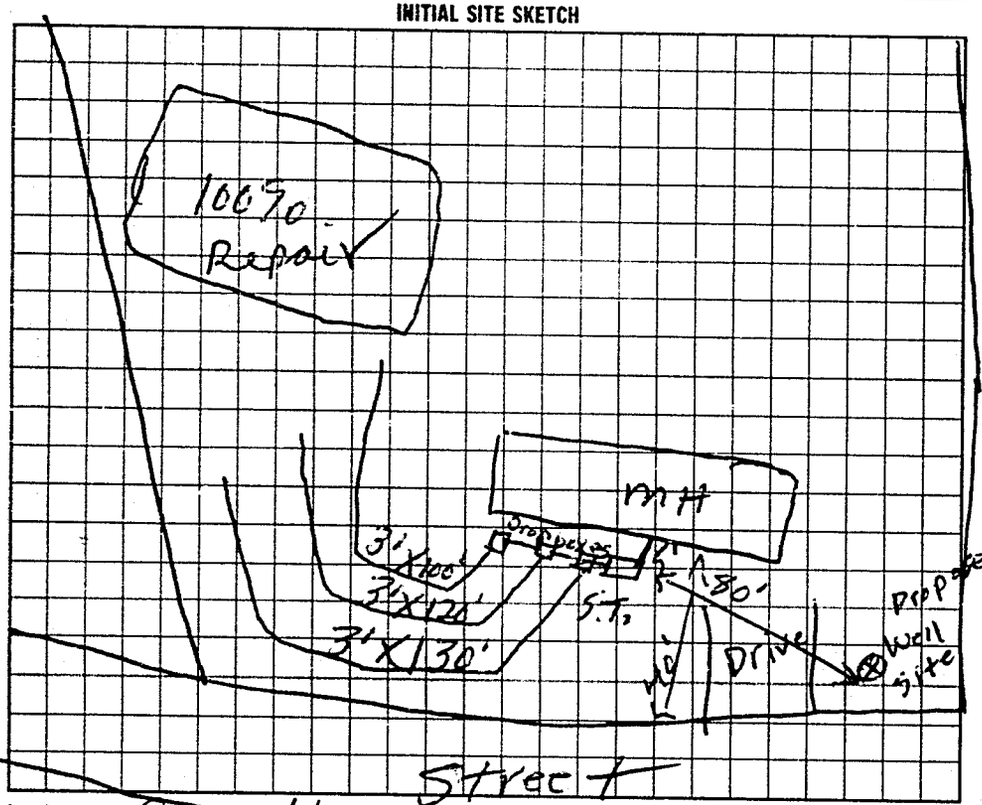

AS BUILT SKETCH

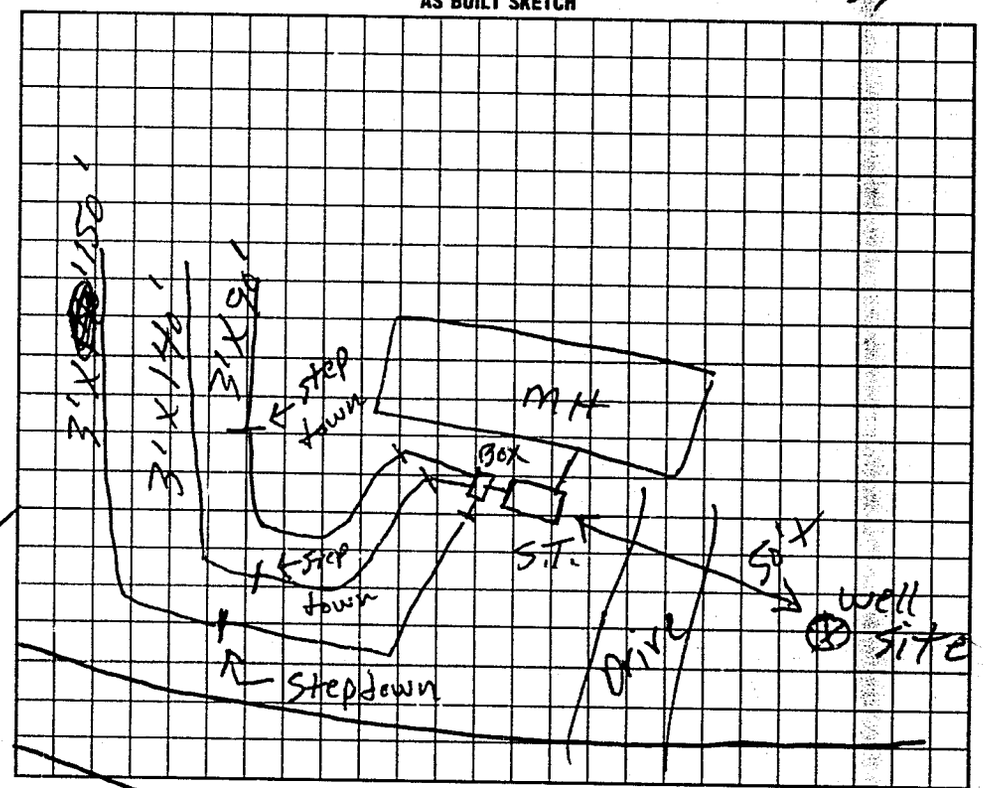

I understand that this permit ~~can be suspended~~ or revoked if any false information is supplied toward securing the permit/any unauthorized changes are made to the site/any unauthorized changes are made in the installation of the system. Improvement Permit is valid for 60 months from date of issuance.

Signed: Evie Huffman

Improvement Permit by: F.C. Moore date 5-11-94

Existing System Inspection by: _____ date _____

Installed by: A-1 Backhoe

Certificate of Completion by: F.C. Moore date 6-22-94

Operation Permit by: _____ date _____

HEALTH DEPT. COPY: WHITE INSPECTION COPY (FINAL): GREEN OWNER COPY (FINAL): YELLOW INSPECTION COPY (INITIAL): PINK OWNER COPY (INITIAL): GOLD