61993

IREDELL COUNTY HEALTH DEPARTMENT

STATESVILLE 704-878-5305 MOORESVILLE 704-664-5281

IMPROVEMENT PERMIT / CERTIFICATE OF COMPLETION / OPERATION PERMIT / EXISTING SYSTEM INSPECTION

PROPERTY DESCRIPTION NO. 24170 DATE 7-11-96 TAX MAP NO. 5B-A-56+57 Watershed: ☐ Yes ☐ No

OWNER OR CONTRACTOR Hazel H. Holshouser PHONE: Business Home 892-5330

ADDRESS 125 Nance Farm Rd mooresville, N.C.

LOCATION Hwy 70 E TR Bethesda Rd TR Reuben Dr. before end on left

SUBDIVISION Beechwood BLOCK / SECTION LOT 56+57 LOT AREA 2.3 acres SITE CLASS. PS DESIGN FLOW 360 L.T.A.R. .3

Septic Tank: 1000 Gallons; STB 1012 Date 7-24-96
Pump Tank: Gallons; PT Date
Pump Make: Model Serial No.
Nitrification Field: No Fields 1 Square Feet 1200 Linear Feet 400
No Lines 4 Trench Width 36" Max Trench Bottom Depth 36" Gravel Depth 12"

☐ New System ☐ Repair System Type: I, II, III, IV, V, VI
System Description: Conv. Gravity
Repair System Description: " "
Maintenance Agreement Required: ☐ Yes ☒ No


☐ House/Mod. Home No. Bedrooms 3
☒ Mobile Home No. Bathrooms 2
☐ Business No. Employees
☐ Other
☐ Slab ☒ Crawl Space ☐ Basement w/plumbing ☐ Basement wo/plumbing

Water Supply: ☒ Individual ☐ Community ☐ Public


Comments:

Comments: well & mH Not on Site at Time of This inspection

INITIAL SITE SKETCH

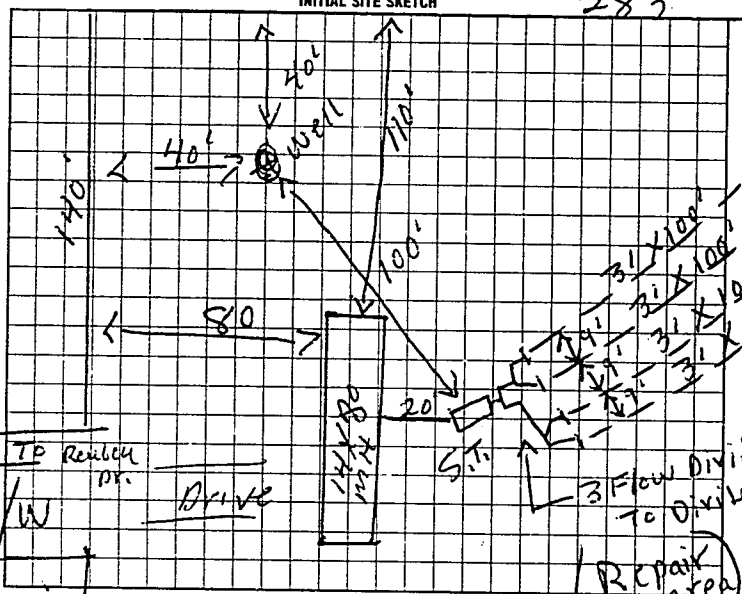

AS BUILT SKETCH

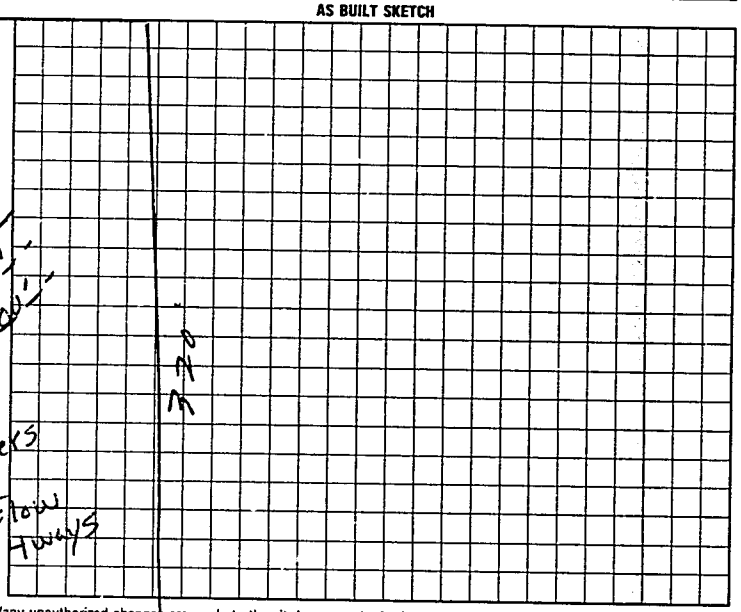

I understand that this permit can be suspended or revoked if any false information is supplied toward securing the permit/any unauthorized changes are made to the site/any unauthorized changes are made in the installation of the system.

Signed: X Hazel H. Holshouser

Improvement Permit by: L. C. Moore date 7-11-96

Existing System Inspection By: L. C. Moore date 7-11-96

Installed by: Donald Faulkner

Certificate of Completion by: date

Operation Permit by: L. C. Moore date 7-16-96

HEALTH DEPT. COPY WHITE — INSPECTION COPY (FINAL) GREEN — OWNER COPY (FINAL) YELLOW — INSPECTION COPY (INITIAL) PINK — OWNER COPY (INITIAL) GOLD

Authorization to Occupy Expires 60 mos from issue

1 2 8 0 0 0