IREDELL COUNTY HEALTH DEPARTMENT

STATESVILLE 704-878-5305 MOORESVILLE 704-664-5281

IMPROVEMENT PERMIT / CERTIFICATE OF COMPLETION / OPERATION PERMIT / EXISTING SYSTEM INSPECTION

PROPERTY DESCRIPTION NO. 22967 DATE 1-30-96 TAX MAP NO. 5B-3-A-68 Watershed: ☐ Yes ☒ No

OWNER OR CONTRACTOR SCOTT BEATTIE PHONE: Business Home 528-9918

ADDRESS RT 1, BOX 259-A, TROUTMAN, NC 28166

LOCATION US 70 E, TR BETHESDA RD, TR REUBEN, LOT ON RIGHT ~ 1000' AT TREES.

SUBDIVISION BEECHWOOD BLOCK / SECTION II LOT 68 LOT AREA ~1 ACRE SITE CLASS PS DESIGN FLOW 300 L.T.A.R. 0.25 GPD/FT²

Septic Tank: 1000 Gallons; STB 321 Date 7-22-96
Pump Tank: Gallons; PT Date
Pump Make: Model Serial No.
Nitrification Field: No Fields 1 Square Feet 1440 Linear Feet 480
No Lines 6 Trench Width 36" Max Trench Bottom Depth 18-36" Gravel Depth 12"

☒ New System ☐ Repair System Type: I, ☒ III, IV, V, VI
System Description: CONV. GRAVITY
Repair System Description: CHAMBERED GRAVITY
Maintenance Agreement Required: ☐ Yes ☒ No

☐ House/Mod. Home No. Bedrooms 3
☒ Mobile Home No. Bathrooms 2
☐ Business No. Employees
☐ Other


☐ Slab ☒ Crawl Space ☐ Basement w/plumbing ☐ Basement wo/plumbing

Water Supply: ☒ Individual ☐ Community ☐ Public WELL


Comments: ① KEEP SYSTEM MINIMUM 100' FROM WELL ② USE FLOW DIVIDER TEE TO ACHIEVE EQUAL DISTRIBUTION INTO TWO DISTRIBUTION BOXES FEEDING THREE LINES EACH ③ INSTALL LINES ON CONTOUR AS SHOWN.

Comments: SYSTEM INSTALLED OUT OF CONTOUR WITH TWO STEP DOWNS — 3'x100' LINE IS ON CONTOUR

INITIAL SITE SKETCH

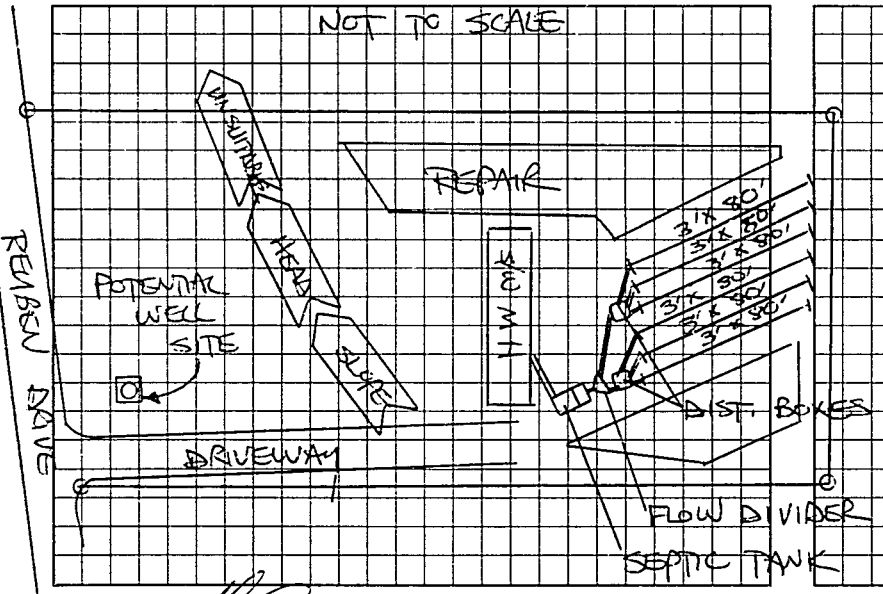

AS BUILT SKETCH

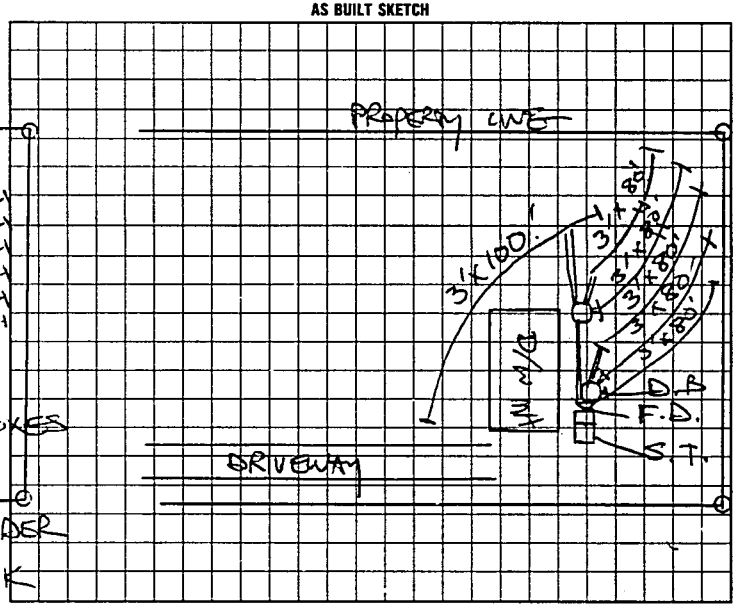

I understand that this permit can be suspended or revoked if any false information is supplied toward securing the permit/any unauthorized changes are made to the site/any unauthorized changes are made in the installation of the system.

AUTHORIZATION TO CONSTRUCT IS VALID FIVE (5) YEARS FROM DATE OF ISSUANCE. IMPROVEMENT PERMIT HAS NO EXPIRATION DATE.

Signed:

Improvement Permit by: STEVE HENDRICK date 1/30/96

~~Certificate of Completion by:~~ date

AUTHORIZATION TO CONSTRUCT ~~Existing system inspection by:~~ STEVE HENDRICK date 4/12/96

Installed by: C & M ENTERPRISES

Operation Permit by STEVE HENDRICK date 8-22-96

HEALTH DEPT. COPY: WHITE INSPECTION COPY (FINAL): GREEN OWNER COPY (FINAL): YELLOW INSPECTION COPY (INITIAL): PINK OWNER COPY (INITIAL): GOLD

187200