Hicapm 9:00

IREDELL COUNTY HEALTH DEPARTMENT

STATESVILLE 704-878-5305 MOORESVILLE 704-664-5281

IMPROVEMENT PERMIT / CERTIFICATE OF COMPLETION / OPERATION PERMIT / EXISTING SYSTEM INSPECTION

PROPERTY DESCRIPTION NO. 20800 DATE 4-17-95 TAX MAP NO. 5B-3-A-55 Watershed: ☐ Yes ☑ No

OWNER OR CONTRACTOR Robert Glenn Warren PHONE: Business Home 664 0278

ADDRESS 117 May Ida Rd Mooresville N.C.

LOCATION 70 E TR Bethesda TR Reuben Tb Jeremy Turn 1st Rd at end on left

SUBDIVISION Beechwood BLOCK / SECTION II LOT 55 LOT AREA 1 acre SITE CLASS. PS DESIGN FLOW 360 L.T.A.R. 13

Septic Tank: 1000 Gallons; STB 825 Date 2-27-95

Pump Tank: Gallons; PT Date

Pump Make: Model Serial No.

Nitrification Field: No Fields 1 Square Feet 1200 Linear Feet 400

No Lines 4 Trench Width 3' Max Trench Bottom Depth 36" Gravel Depth 12"

☑ New System ☐ Repair System Type: I II III IV V VI

System Description: Conv Gravity

Repair System Description: Pump To Conv Lines

Maintenance Agreement Required: ☐ Yes ☑ No

☐ House/Mod. Home No. Bedrooms 3

☑ Mobile Home No. Bathrooms 2

☐ Business No. Employees


☐ Other

☐ Slab ☐ Crawl Space ☐ Basement w/plumbing ☐ Basement wo/plumbing

Water Supply: ☑ Individual ☐ Community ☐ Public


Comments:

INITIAL SITE SKETCH

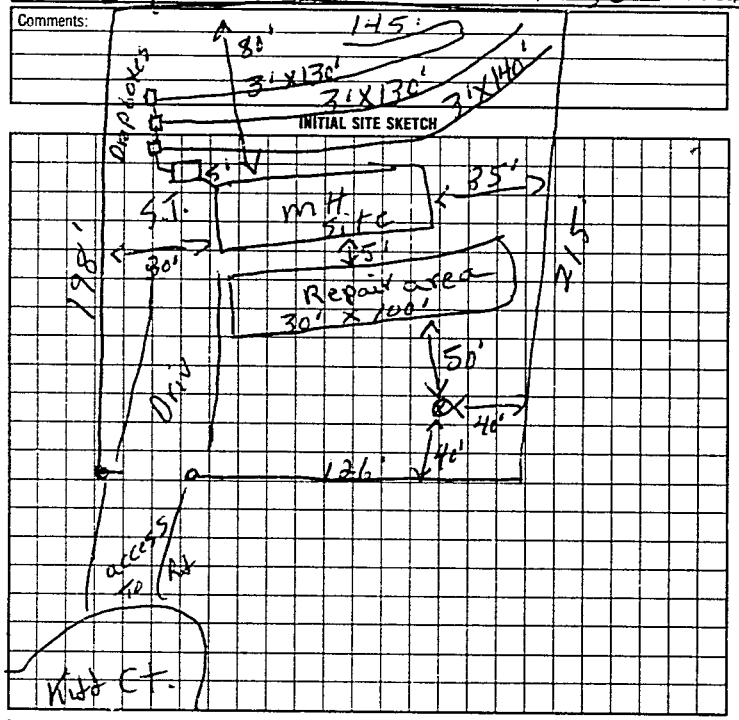

Comments:

AS BUILT SKETCH

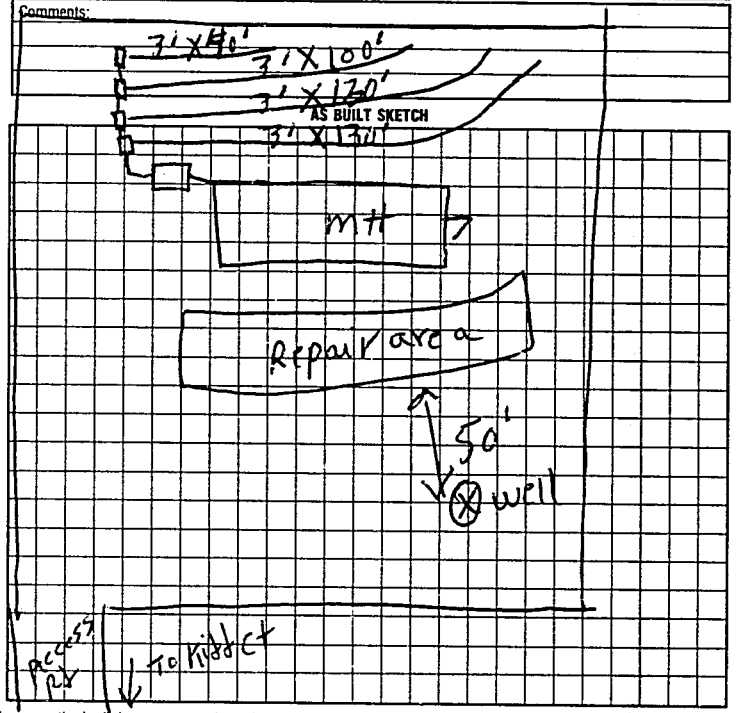

I understand that this permit can be suspended or revoked if any false information is supplied toward securing the permit/any unauthorized changes are made to the site/any unauthorized changes are made in the installation of the system. Improvement Permit is valid for 60 months from date of issuance.

Signed: Robert G. Warren

Improvement Permit by: f-C. moore date 4-17-95

Existing System Inspection by: date

Installed by: Curt Dunning

Certificate of Completion by: f-C. moore date 5-9-95

Operation Permit by: date

HEALTH DEPT COPY: WHITE INSPECTION COPY (FINAL): GREEN OWNER COPY (FINAL): YELLOW INSPECTION COPY (INITIAL): PINK OWNER COPY (INITIAL): GOLD

20220