4:00

IREDELL COUNTY HEALTH DEPARTMENT

STATESVILLE 704-878-5305 MOORESVILLE 704-664-5281

IMPROVEMENT PERMIT / CERTIFICATE OF COMPLETION / OPERATION PERMIT / EXISTING SYSTEM INSPECTION

PROPERTY DESCRIPTION NO. 20090 DATE 11-27-95 TAX MAP NO. 513-3-A- 74+75 Watershed: ☐ Yes ☐ No

OWNER OR CONTRACTOR Jimmy Stewart PHONE: Business Home 664 0883

ADDRESS 806 River Rd Mooresville, N.C.

LOCATION I-77 TR Bethela TR Ruben Dr 1/4 mi left

SUBDIVISION Beechwood BLOCK / SECTION II LOT 74 + 75 LOT AREA 1.061 acres SITE CLASS. PS DESIGN FLOW 540 L.T.A.R. .13

Septic Tank: 1000 Gallons; STB 821 Date 10-4-95

Pump Tank: Gallons; PT Date

Pump Make: Model Serial No.

Nitrification Field: No Fields 1 Square Feet 810 Linear Feet 270

No Lines 3 Trench Width 36" Max Trench Bottom Depth 36" Gravel Depth 12"

☑ New System ☐ Repair System Type: I, II, III, IV, V, VI

System Description: Conv. Gravity

Repair System Description: " "

Maintenance Agreement Required: ☐ Yes ☑ No

☐ House/Mod. Home No. Bedrooms 2

☑ Mobile Home No. Bathrooms 2

☐ Business No. Employees

☐ Other


☐ Slab ☑ Crawl Space ☐ Basement w/plumbing ☐ Basement w/o plumbing

Water Supply: ☑ Individual ☐ Community ☐ Public


Comments: Replaces Permits To Scott Beattie lot 74 + lot 75 issued 1-20-95

Comments:

INITIAL SITE SKETCH

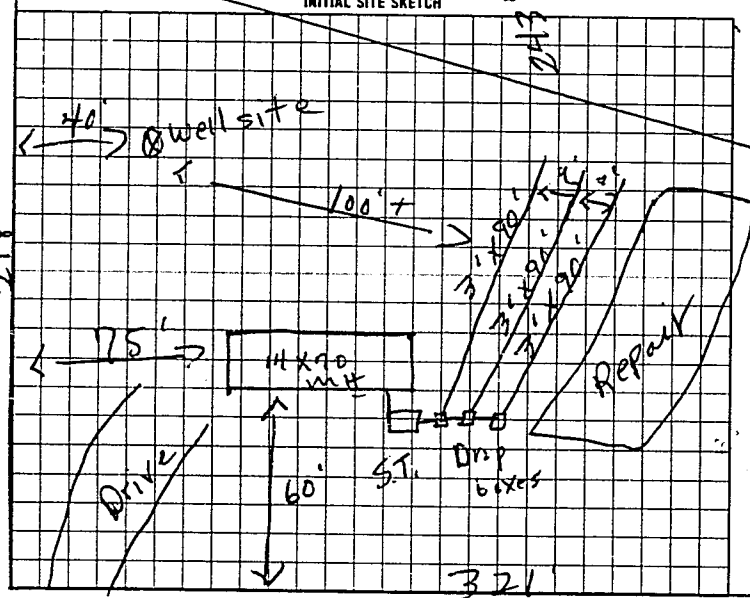

AS BUILT SKETCH

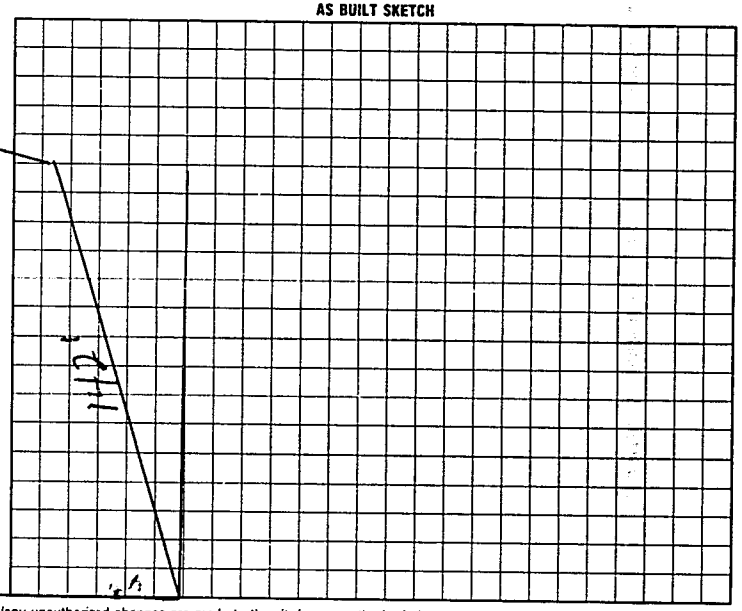

I understand that this permit can be suspended or revoked if any false information is supplied toward securing the permit/any unauthorized changes are made to the site/any unauthorized changes are made in the installation of the system.

Signed: X Jimmy W. Stewart

Improvement Permit by: authorization to const P.C. Moore date 11-29-95

Existing System Inspection by: P.C. Moore date 11-29-95

Installed by: G & M Enterprises

Certificate of Completion by: P.C. Moore date 12-22-95

Operation Permit by: date

+ to construct DEPT. COPY WHITE INSPECTION COPY (FINAL) GREEN OWNER COPY (FINAL) YELLOW INSPECTION COPY (INITIAL) PINK OWNER COPY (INITIAL) GOLD

authorization to const Expires 60 mos from issue date

6681U0