52844

IREDELL COUNTY HEALTH DEPARTMENT

STATESVILLE 704-878-5305 MOORESVILLE 704-664-5281

IMPROVEMENT PERMIT / CERTIFICATE OF COMPLETION / OPERATION PERMIT / EXISTING SYSTEM INSPECTION

PROPERTY DESCRIPTION NO. 19397 DATE 9-19-94 TAX MAP NO. 58-3-A-69 Watershed: ☐ Yes ☑ No

OWNER OR CONTRACTOR Herbert R. Campfield PHONE: Business _____ Home 873-0252

ADDRESS 1902 Lynnwood Sta NC

LOCATION 70 E TR Bethesda RX TR Ruben Drive 1/4 mi on Rt.

SUBDIVISION Beechwood BLOCK / SECTION II LOT 67 LOT AREA 1.019 acres SITE CLASS. PS DESIGN FLOW 360 L.T.A.R. .35

Septic Tank: 1000 Gallons; STB 1012 Date 8-1-94
Pump Tank: _____ Gallons; PT _____ Date _____
Pump Make: _____ Model _____ Serial No. _____
Nitrification Field: No Fields 1 Square Feet 1050 Linear Feet 350
No Lines 4 Trench Width 36" Max Trench Bottom Depth 36" Gravel Depth 12"

☐ New System ☐ Repair System Type: I ☑ II III, IV, V, VI
System Description: Conv. Gravity
Repair System Description: " " "
Maintenance Agreement Required: ☐ Yes ☐ No

☑ House/Mod. Home No. Bedrooms 3
☐ Mobile Home No. Bathrooms 2
☐ Business No. Employees ____
☐ Other _____


☐ Slab ☑ Crawl Space ☐ Basement w/plumbing ☐ Basement wo/plumbing

Water Supply:
☑ Individual
☐ Community
☐ Public

Comments:

Comments: well was not located at time of this inspection place as shown on sketch

INITIAL SITE SKETCH

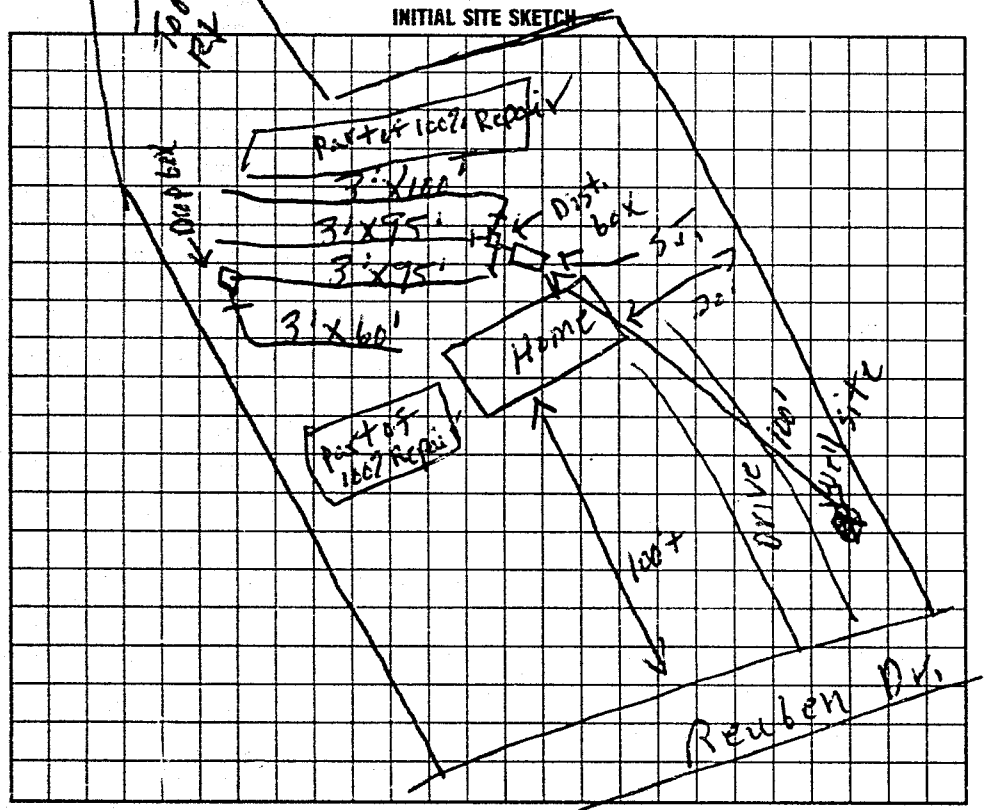

AS BUILT SKETCH

Same as initial Sketch

I understand that this permit can be suspended or revoked if any false information is supplied toward securing the permit/any unauthorized changes are made to the site/any unauthorized changes are made in the installation of the system. Improvement Permit is valid for 60 months from date of issuance.

Signed: x Dair Campfield

Improvement Permit by: J.C. Moore date 9-19-94

Existing System Inspection by: _____ date _____

Installed by: J.C. Forsyth

Certificate of Completion by: J.C. Moore date 10-19-94

Operation Permit by: _____ date _____

HEALTH DEPT COPY: WHITE INSPECTION COPY (FINAL): GREEN OWNER COPY (FINAL): YELLOW INSPECTION COPY (INITIAL): PINK OWNER COPY (INITIAL): GOLD