IREDELL COUNTY HEALTH DEPARTMENT

Statesville Office (704) 878-5305 Mooresville Office (704) 660-3625 PERMIT # 273073

IMPROVEMENT PERMIT / AUTHORIZATION TO CONSTRUCT / OPERATION PERMIT / EXISTING SYSTEM

PIN # 4761293814

APPLICANT: William Maxwell APPLICANT ADDRESS: 167 Glaspy Rd Statesville NC 28677

SITE ADDRESS: 167 Glaspy Rd Statesville NC 28677 PHONE: 704-528-6718 ALT. PHONE: N/A

SITE DIRECTIONS: 70 E T/R Bethesda Rd T/R Glaspy Rd Lot on left

SUBDIVISION: N/A SECTION: N/A LOT # N/A LOT AREA: 1.5 ac DESIGN FLOW: 240 L.T.A.R.: Ex


Septic Tank	Ex	(gal)	STB		Date	☐ New System	☐ Repair	☐ Expansion	System Type: I II III IV V VI	☑ Residence	No. Bedrooms 2
Pump Tank		(gal)	PT		Date	System Description: Existing				☐ Business	No. Persons 4
Pump Make		Model			Serial #	Repair System Description:				☐ Other	No. Employees
# Nitrification Fields	Ex	# Lines	Ex		Linear Ft: Ex	Maintenance Agreement Required:	☐ YES	☑ NO		☐ Slab	☒ Crawl Space
Trench Width	Ex	Max. Trench Bottom Depth	Ex		Gravel Depth Ex		☒ GRAVITY	☐ PRESSURE		☐ Basement w/plumbing	☐ Basement w/o plumbing

Water Supply: ☐ Private ☐ Public ☐ Community

Comments / Conditions: All building foundations must be ≥5' from any part of STS and ≥25' from any well

INITIAL SITE SKETCH

AS BUILT SKETCH

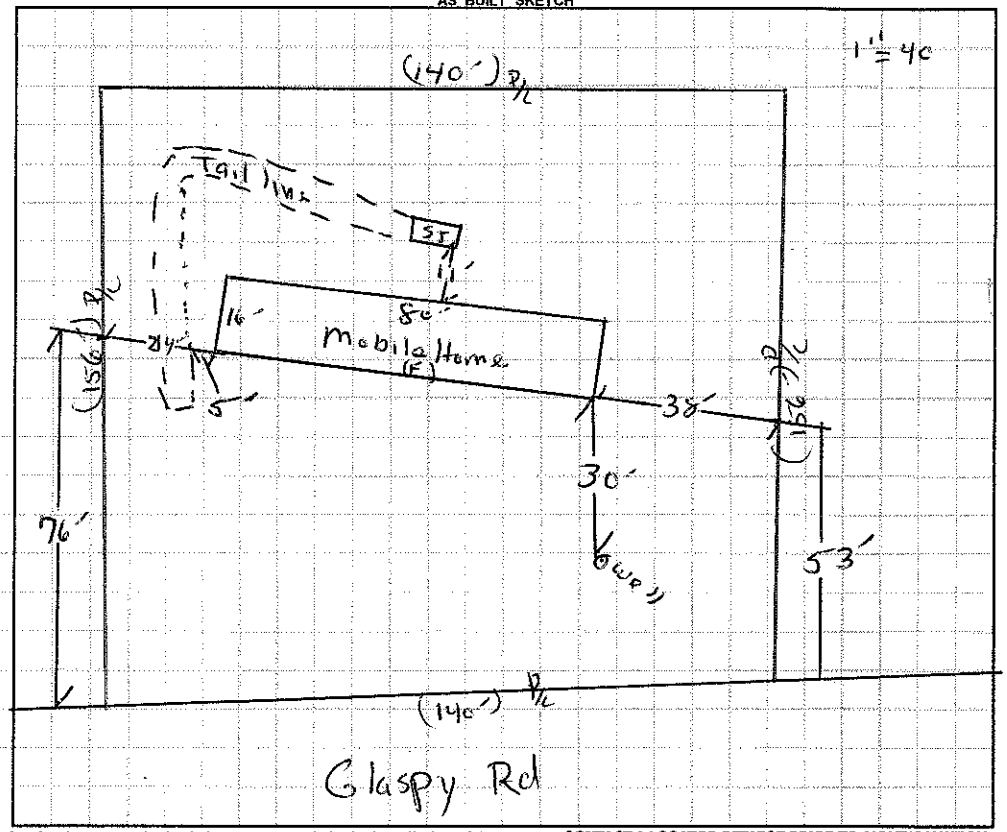

Permit can be suspended or revoked if any false information is supplied toward securing the permit / any unauthorized changes are made to the site / any unauthorized changes are made in the installation of the system. **CONTACT A LOCATOR SERVICE PRIOR TO ANY EXCAVATION**

☐ **IMPROVEMENT PERMIT** *with plat valid without expiration.* ☐ **IMPROVEMENT PERMIT** *with site plan valid for 60 mos.* ☐ **AUTHORIZATION TO CONSTRUCT** *valid for period equal to IMPROVEMENT PERMIT--not to exceed 60 mo.*

Owner / Applicant Signature: William Maxwell Date: 12-14-16 Installed by:

IMPROVEMENT PERMIT by: Date: OPERATION PERMIT by: Date:

AUTHORIZATION TO CONSTRUCT by: Date: Existing System Inspected by: Date: 12/14/16

Health Dept. Copy - WHITE Applicant (Final Approval) - YELLOW Applicant (Conditional Approval) - PINK