IREDELL COUNTY HEALTH DEPARTMENT

STATESVILLE 704-878-5305 MOORESVILLE 704-664-5281

IMPROVEMENT PERMIT / CERTIFICATE OF COMPLETION / OPERATION PERMIT / EXISTING SYSTEM INSPECTION

PROPERTY DESCRIPTION NO. 20089 Beattie DATE 1-20-95 TAX MAP NO. 58-3-A-73 Watershed: ☐ Yes ☑ No

OWNER OR CONTRACTOR Scott Beattie PHONE: Business Home

ADDRESS Rt Box 259-A Troutman, N.C.

LOCATION Hwy 70E TR Bethesda Rd TR Reuben Lane 6th lot Left

SUBDIVISION Beechwood BLOCK / SECTION II LOT 73 LOT AREA .537 acres SITE CLASS. PS DESIGN FLOW 360 L.T.A.R. 1.3

Septic Tank: 1000 Gallons; STB 871 Date 11-1-95

Pump Tank: Gallons; PT Date

Pump Make: Model Serial No.

Nitrification Field: No Fields 1 Square Feet 1200 Linear Feet 400

No Lines 4 Trench Width 36" Max Trench Bottom Depth 36" Gravel Depth 12"

☑ New System ☐ Repair System Type: I, II, III, IV, V, VI

System Description: Conv. Gravity

Repair System Description: Porus Block Panel

Maintenance Agreement Required: ☐ Yes ☑ No

☑ House/Mod. Home No. Bedrooms 3

☑ Mobile Home No. Bathrooms 2

☐ Business No. Employees

☐ Other


☐ Slab ☑ Crawl Space ☐ Basement w/plumbing ☐ Basement wo/plumbing

Water Supply: ☑ Individual ☐ Community ☐ Public


Comments:

Comments: Well & mobile Home Not on site at this inspection

INITIAL SITE SKETCH

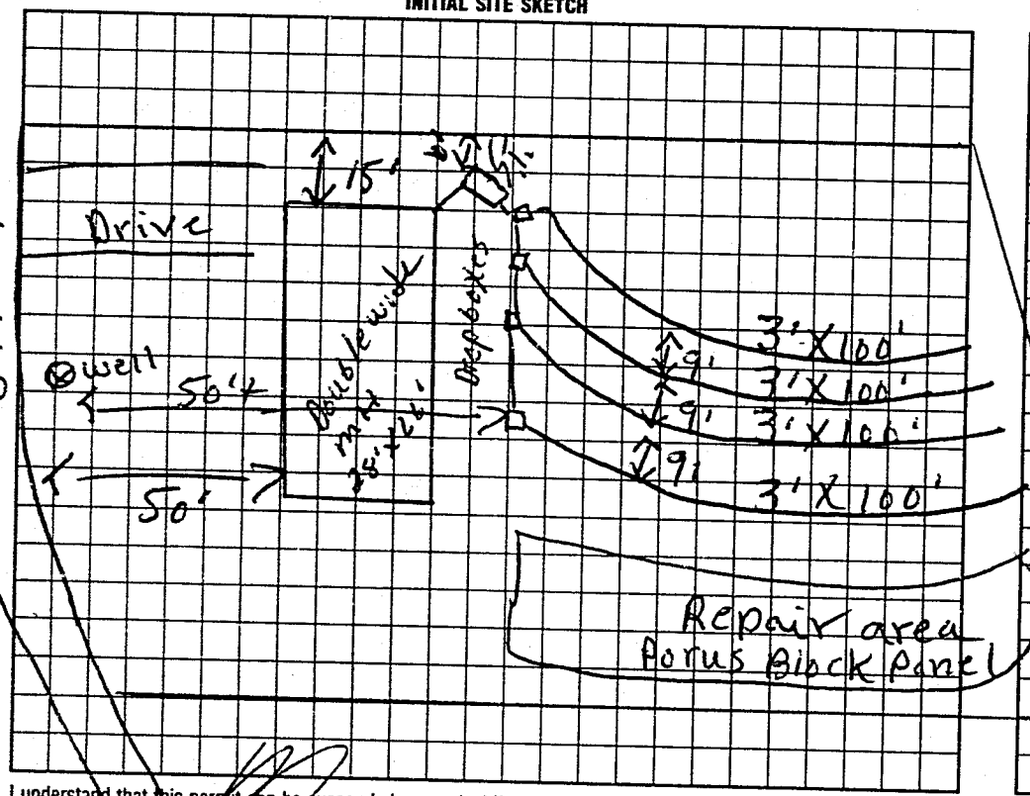

AS BUILT SKETCH

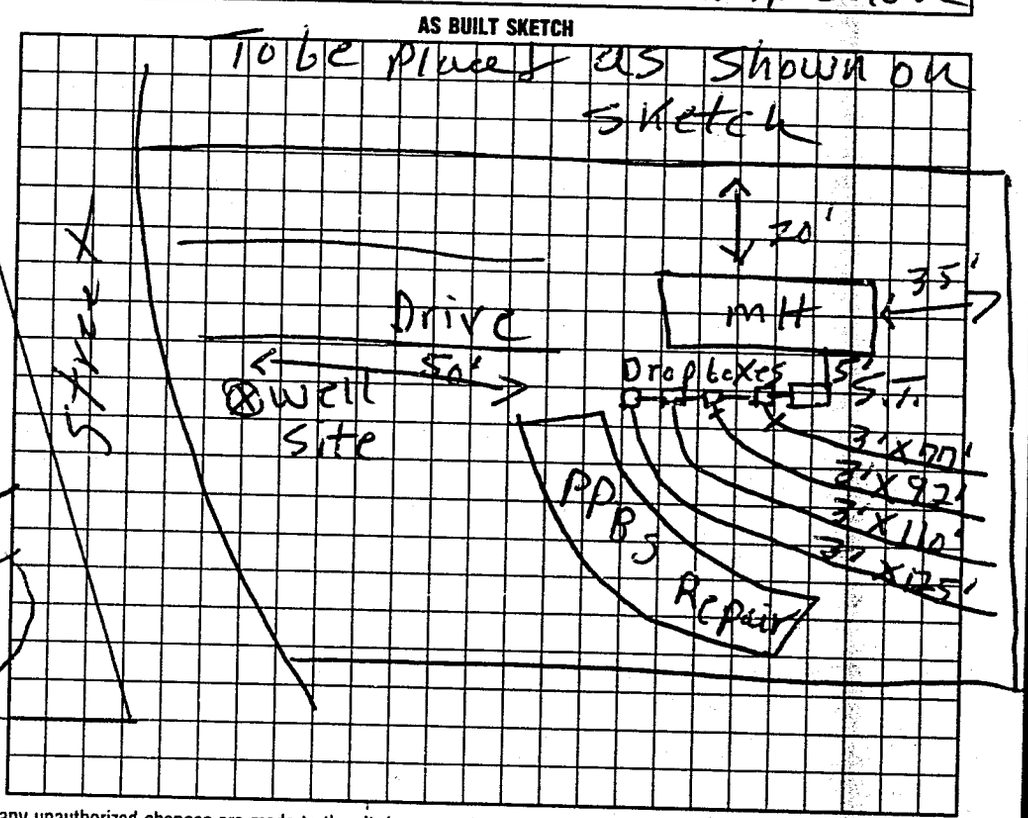

I understand that this permit can be suspended or revoked if any false information is supplied toward securing the permit/any unauthorized changes are made to the site/any unauthorized changes are made in the installation of the system. Improvement Permit is valid for 60 months from date of issuance.

Signed:

Improvement Permit by: R. C. Moore date 1-20-95

Existing System Inspection by: date

Installed by: Gary Miller GEM Enterprizes

Certificate of Completion by: date

Operation Permit by: R. C. Moore date 12-22-95

HEALTH DEPT. COPY, WHITE — INSPECTION COPY (FINAL) GREEN — OWNER COPY (FINAL) YELLOW — INSPECTION COPY (INITIAL) PINK — OWNER COPY (INITIAL) GOLD

0 9 6 2 0 0