55008

IREDELL COUNTY HEALTH DEPARTMENT

STATESVILLE 704-878-5305 MOORESVILLE 704-664-5281

IMPROVEMENT PERMIT / CERTIFICATE OF COMPLETION / OPERATION PERMIT / EXISTING SYSTEM INSPECTION

PROPERTY DESCRIPTION NO. 20376 DATE 2-27-95 TAX MAP NO. 56-3-A-70 Watershed: ☐ Yes ☒ No

OWNER OR CONTRACTOR Randell Keith Goad PHONE: Business _____ Home 704-278-1429

ADDRESS PO Box 155 Woodleaf N.C. 27054

LOCATION 70E TR Bethesda before int TR Reuben Yadkin Rd.

SUBDIVISION Beechwood BLOCK / SECTION _____ LOT 70 LOT AREA 100X212 SITE CLASS. P5 DESIGN FLOW 360 L.T.A.R. 1

Septic Tank: 1000 Gallons; STB 760 Date 1-20-95

Pump Tank: _____ Gallons; PT _____ Date _____

Pump Make: _____ Model _____ Serial No. _____

Nitrification Field: No Fields 1 Square Feet 1110 Linear Feet 370

No Lines 4 Trench Width 36" Max Trench Bottom Depth 36" Gravel Depth 12"

☒ New System ☐ Repair System Type: I, II, III, IV, V, VI

System Description: Conv. Gravity

Repair System Description: " "

Maintenance Agreement Required: ☐ Yes ☒ No

☐ House/Mod. Home ☒ Mobile Home ☐ Business ☐ Other

No. Bedrooms 3 No. Bathrooms 2 No. Employees ____


☐ Slab ☒ Crawl Space ☐ Basement w/plumbing ☐ Basement wo/plumbing

Water Supply: ☒ Individual ☐ Community ☐ Public


Comments:

Comments: Home and well located at time of inspection. Both required distances from septic system.

INITIAL SITE SKETCH

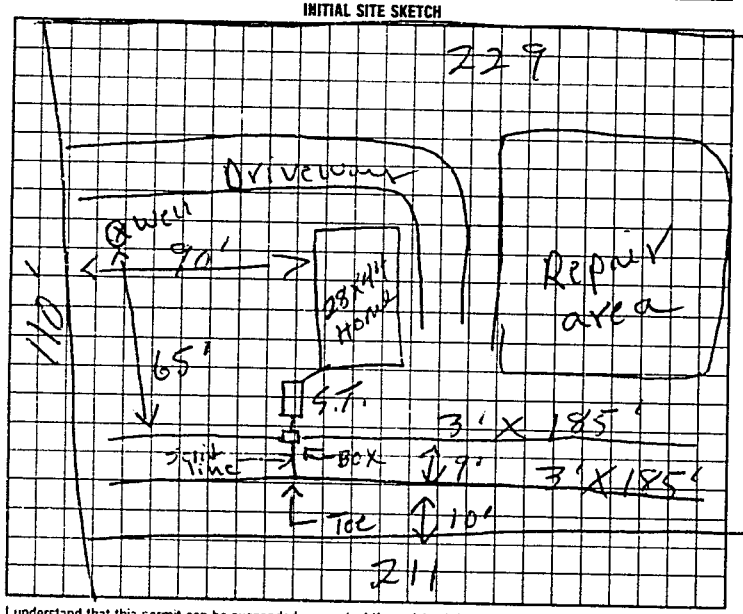

AS BUILT SKETCH

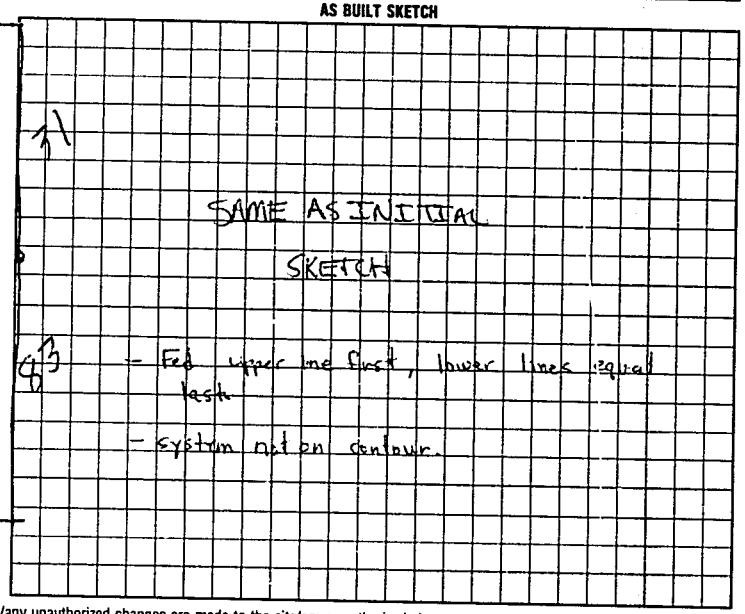

I understand that this permit can be suspended or revoked if any false information is supplied toward securing the permit/any unauthorized changes are made to the site/any unauthorized changes are made in the installation of the system. Improvement Permit is valid for 60 months from date of issuance.

Signed: x Randell Keith Goad

Improvement Permit by: R.C. Moore date 2-27-95

Existing System Inspection by: _____ date _____

Installed by: Larry Powell

Certificate of Completion by: Michael J. Dennis date 3-22-95

Operation Permit by: _____ date _____

HEALTH DEPT COPY WHITE INSPECTION COPY (FINAL) GREEN OWNER COPY (FINAL) YELLOW INSPECTION COPY (INITIAL) PINK OWNER COPY (INITIAL) GOLD

ESE000