IREDELL COUNTY HEALTH DEPARTMENT

STATESVILLE 704-878-5305 MOORESVILLE 704-664-5281

IMPROVEMENT PERMIT / CERTIFICATE OF COMPLETION / OPERATION PERMIT / EXISTING SYSTEM INSPECTION

PROPERTY DESCRIPTION NO 22966 DATE 1-30-96 TAX MAP NO 5B-3-A-20 Watershed Yes ✓ No

OWNER OR CONTRACTOR SCOTT BEATTIE PHONE Business Home 528-9913

ADDRESS RT. 1 BOX 259 A, TROUTMAN, NC 28166 Kidd

LOCATION US 70 E, TR BETHESDA, TR REUBEN, TL JEREMY LANE, TR ASHLEY COURT AT END ON LEFT

SUBDIVISION BEECHWOODS BLOCK / SECTION II LOT 53 LOT AREA 0.617 ACRE SITE CLASS PS DESIGN FLOW 360 L.T.A.R 0.3 GPD/FT

Septic Tank 1000 Gallons STB 821 Date 3-16-97
Pump Tank: Gallons PT Date
Pump Make: Model Serial No
Nitrification Field: No Fields 1 Square Feet 1200 Linear Feet 400
No Lines 4 Trench Width 36" Max Trench Bottom Depth 18-36" Gravel Depth 12"

✓ New System Repair System Type I II III IV V
System Description CONVENTIONAL GRAVITY
Repair System Description CONV. GRAVITY
Maintenance Agreement Required Yes ✓ No
Slab ✓ Crawl Space Basement w/plumbing Basement wo/plumbing


✓ House/Mod Home ✓ Mobile Home Business Other
No Bedrooms 3 No Bathrooms 2 No Employees

Water Supply ✓ Individual Community Public WELL


Comments: ① KEEP SYSTEM MAXIMUM FEASIBLE DISTANCE FROM WELLS, NO LESS THAN 50' ② USE TREE FLOW DIVIDER TEES TO ACHIEVE EQUAL DISTRIBUTION INTO FOUR 100' LINES INSTALLED ON CONTOUR

Comments:

INITIAL SITE SKETCH

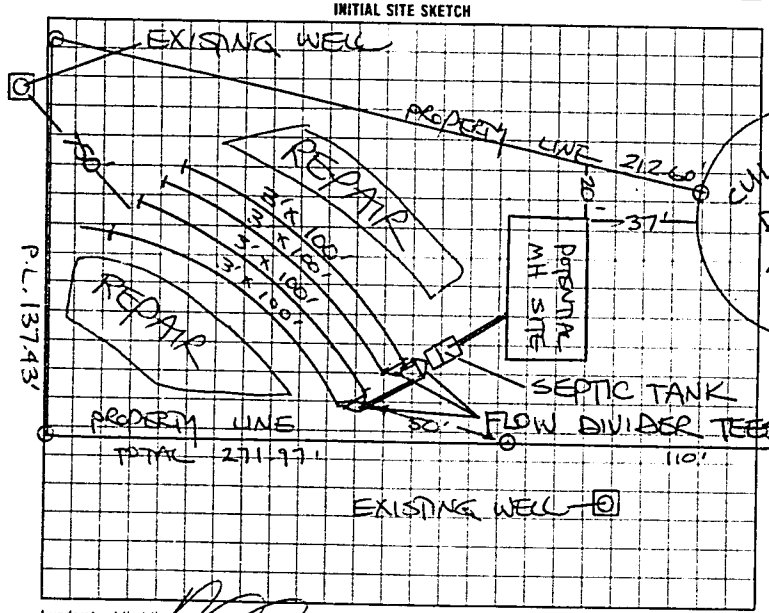

AS BUILT SKETCH

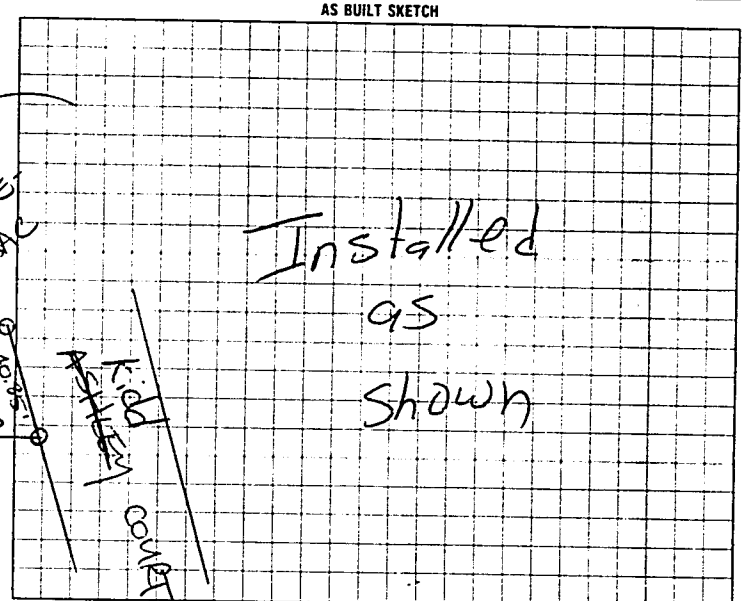

I understand that this permit can be suspended or revoked if any false information is supplied toward securing the permit/any unauthorized changes are made to the site/any unauthorized changes are made in the installation of the system.

AUTHORIZATION TO CONSTRUCT IS VALID FIVE (5) YEARS FROM DATE OF ISSUANCE. IMPROVEMENT PERMIT HAS NO EXPIRATION DATE.

Signed X

Improvement Permit by STEVE HEDRICK date 1-30-96 Installed by G+M Enterprises

AUTHORIZATION TO CONSTRUCT Existing System Inspection by STEVE HEDRICK date 4-12-96 Certificate of Completion by date

Operation Permit by date 4-18-97

HEALTH DEPT COPY WHITE INSPECTION COPY (PINK) GREEN OWNER COPY (PINK) YELLOW INSPECTION COPY (INITIAL) PINK OWNER COPY (INITIAL) GOLD

003072