IREDELL COUNTY HEALTH DEPARTMENT

STATESVILLE 704-878-5305 MOORESVILLE 704-664-5281

IMPROVEMENT PERMIT / CERTIFICATE OF COMPLETION / OPERATION PERMIT / EXISTING SYSTEM INSPECTION

PROPERTY DESCRIPTION NO. 20088 DATE 1-20-95 TAX MAP NO. 58-3-A-72 Watershed: ☐ Yes ☑ No

OWNER OR CONTRACTOR Scott Battie PHONE: Business Home

ADDRESS Rt 1 Box 259-A Troutman N.C.

LOCATION Hwy 70E TR Bethesda RD TR Reuben Lane 5th lot left

SUBDIVISION Beechwood BLOCK / SECTION II LOT 72 LOT AREA 1.585 SITE CLASS. A B DESIGN FLOW 360 L.T.A.R. 1.3

Septic Tank: 1000 Gallons; STB 821 Date 11-9-94

Pump Tank: Gallons; PT Date

Pump Make: Model Serial No.

Nitrification Field: No Fields 1 Square Feet 1200 Linear Feet 400

No Lines 5 Trench Width 36" Max Trench Bottom Depth 36" Gravel Depth 12"

☑ New System ☐ Repair System Type: I, II, III, IV, V, VI

System Description: Conv. Gravity

Repair System Description: Perus Black Panel

Maintenance Agreement Required: ☐ Yes ☐ No

☐ House/Mod. Home ☑ Mobile Home ☐ Business ☐ Other

No. Bedrooms 3 No. Bathrooms 2 No. Employees


☐ Slab ☑ Crawl Space ☐ Basement w/plumbing ☐ Basement w/o plumbing

Water Supply: ☐ Individual ☐ Community ☐ Public


Comments: Run Drain lines on contour of slope

Comments:

INITIAL SITE SKETCH

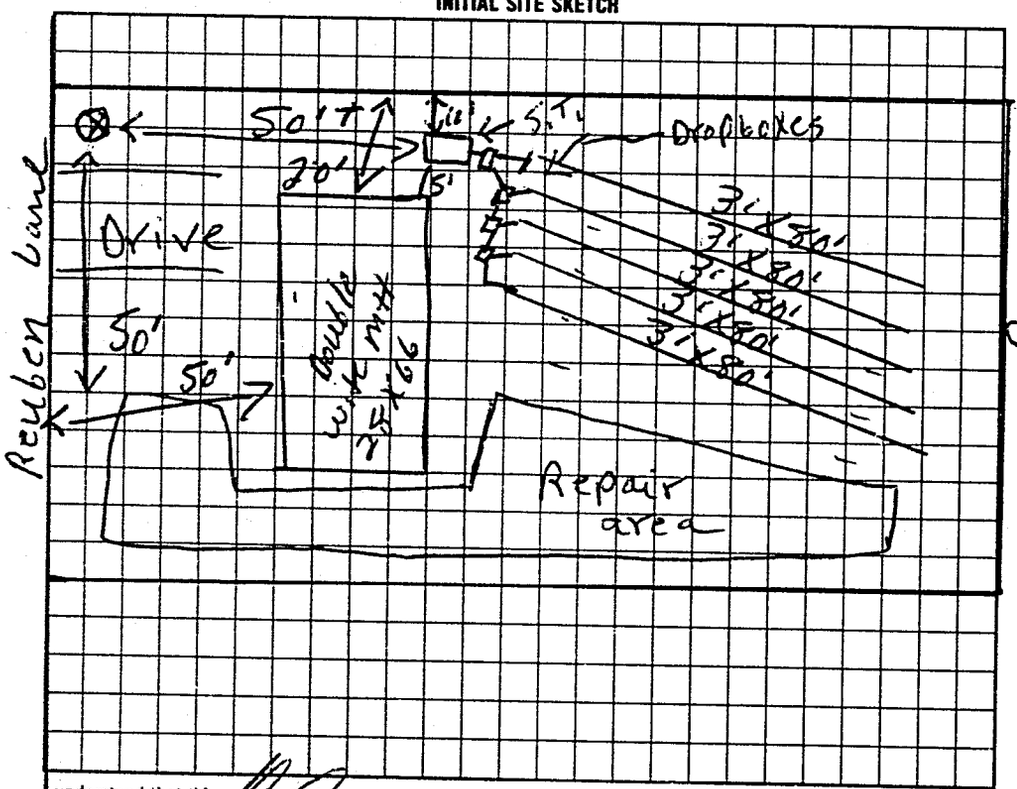

AS BUILT SKETCH

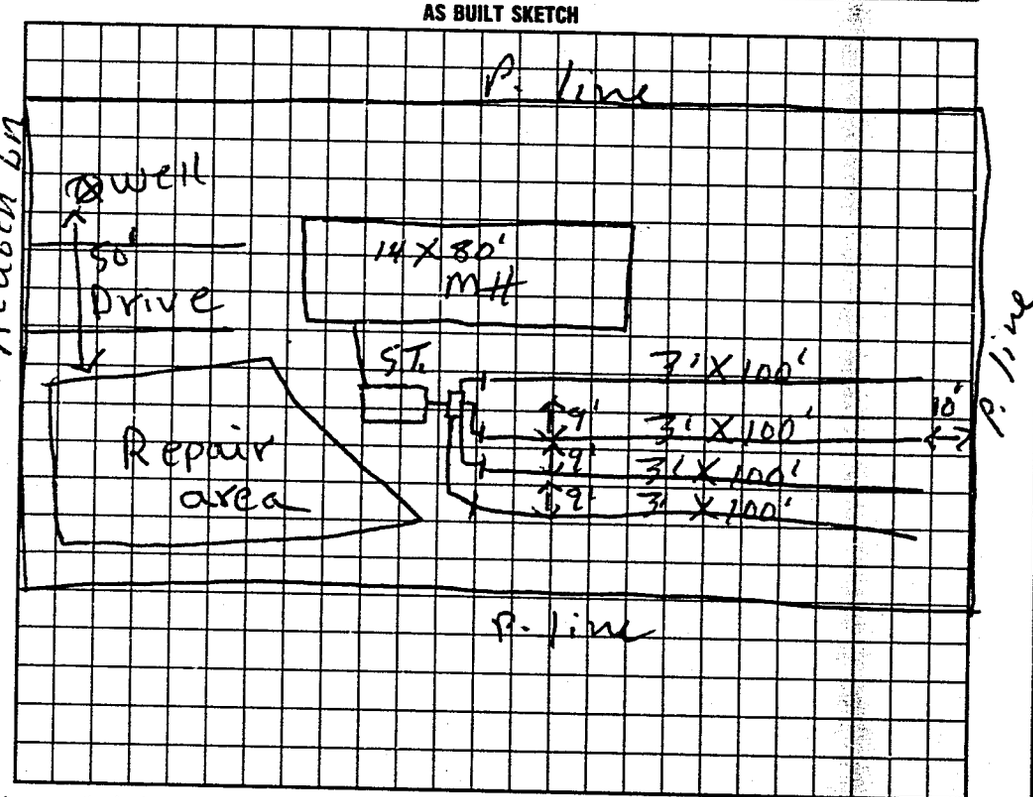

I understand that this permit can be suspended or revoked if any false information is supplied toward securing the permit/any unauthorized changes are made to the site/any unauthorized changes are made in the installation of the system. Improvement Permit is valid for 60 months from date of issuance.

Signed:

Improvement Permit by: R. C. Moore date 1-20-95

Existing System Inspection by: date

Installed by: G & M Enterprizes

Certificate of Completion by: R. C. Moore date 7-12-95

Operation Permit by: date

HEALTH DEPT. COPY: WHITE INSPECTION COPY (FINAL): GREEN OWNER COPY (FINAL): YELLOW INSPECTION COPY (INITIAL): PINK OWNER COPY (INITIAL): GOLD

8 9 6 2 0 0