IREDELL COUNTY HEALTH DEPARTMENT

STATESVILLE 704-878-5305 MOORESVILLE 704-664-5281

53888

IMPROVEMENT PERMIT / CERTIFICATE OF COMPLETION / OPERATION PERMIT / EXISTING SYSTEM INSPECTION

PROPERTY DESCRIPTION NO. 19860 DATE 12-8-94 TAX MAP NO. 5B-3-A-51 Watershed: ☐ Yes ☑ No

OWNER OR CONTRACTOR Dennis Hayden PHONE: Business Home 528-9795

ADDRESS PO Box 5124 Statesville

LOCATION 70E TR Bethania TR Reuben TL Jeremy TR Kittet to end

SUBDIVISION Beechwood BLOCK / SECTION II LOT 51 LOT AREA .65 acres SITE CLASS PS DESIGN FLOW 360 L.T.A.R. .35

Septic Tank: 1000 Gallons; STB 1012 Date 9-21-94

Pump Tank: Gallons; PT Date

Pump Make: Model Serial No.

Nitrification Field: No Fields 1 Square Feet 1035 Linear Feet 345

No Lines 4 Trench Width 36" Max Trench Bottom Depth 31" Gravel Depth 12"

☐ New System ☐ Repair System Type: I, II, III, IV, V, VI

System Description: Conv. Gravity

Repair System Description: Pump To Conv.

Maintenance Agreement Required: ☐ Yes ☐ No

☑ House/Mod. Home No. Bedrooms 3

☐ Mobile Home No. Bathrooms 2

☐ Business No. Employees

☐ Other


☐ Slab ☑ Crawl Space ☐ Basement w/plumbing ☐ Basement wo/plumbing

Water Supply: ☑ Individual ☐ Community ☐ Public

Comments:

125'

INITIAL SITE SKETCH

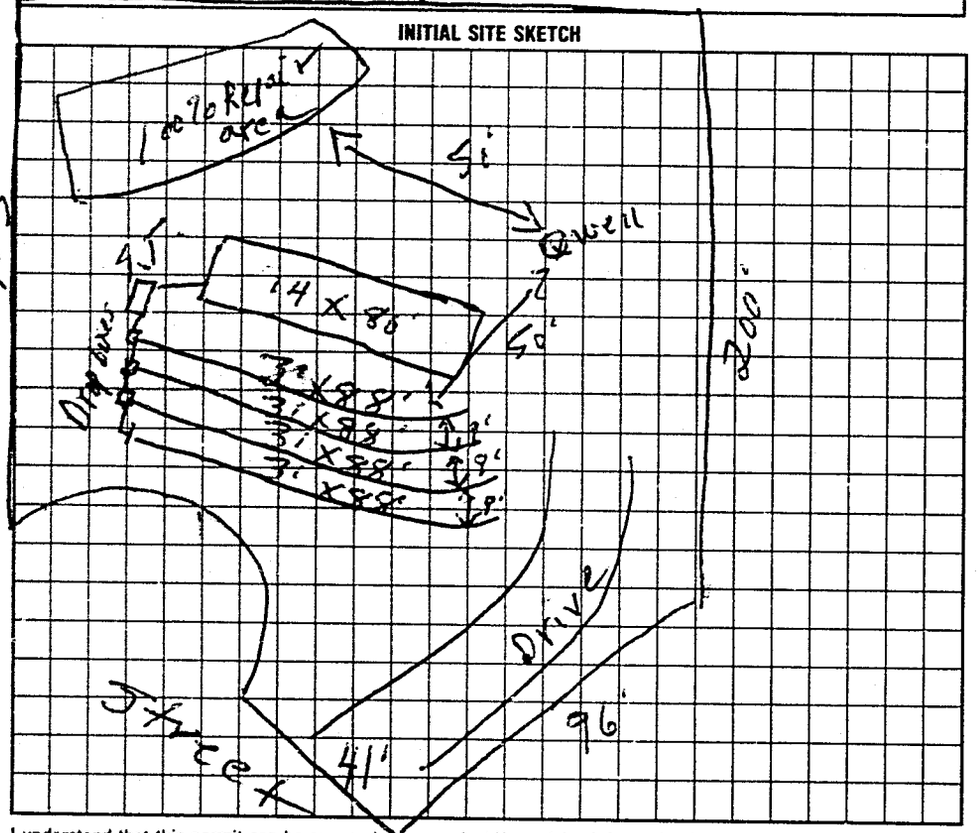

Comments:

AS BUILT SKETCH

Same as initial Sketch

I understand that this permit can be suspended or revoked if any false information is supplied toward securing the permit/any unauthorized changes are made to the site/any unauthorized changes are made in the installation of the system. Improvement Permit is valid for 60 months from date of issuance.

Signed: Dennis J. Hayden

Improvement Permit by: L. C. Moore date 12-8-94

Existing System Inspection by date

Installed by: Anty Daniels

Certificate of Completion by: L. C. Moore date 12-22-94

Operation Permit by date

HEALTH DEPT. COPY: WHITE INSPECTION COPY (FINAL): GREEN OWNER COPY (FINAL): YELLOW INSPECTION COPY (INITIAL): PINK OWNER COPY (INITIAL): GOLD

956000