IREDELL COUNTY HEALTH DEPARTMENT

STATESVILLE 704-878-5305 MOORESVILLE 704-664-5281 ad

IMPROVEMENT PERMIT / AUTHORIZATION TO CONSTRUCT / OPERATION PERMIT / EXISTING SYSTEM INSPECTION

PERMIT# 151643 PIN# 4761297240 DATE 7-25-08

OWNER OR APPLICANT Dennis Hayden PHONE: Business 704-873-2547 Home

ADDRESS 114 Kidd Ct Statesville NC 28677

LOCATION Bethesda, RD Rubin TO Jeremy

SUBDIVISION Beechwood BLOCK / SECTION 11 LOT 51 LOT AREA .7 SITE CLASS. BS DESIGN FLOW 360 L.T.A.R.

Septic Tank: ~~Existing~~ Gallons: STB 1012 Date 4-21-94

Pump Tank: Gallons: PT Date

Pump Make: Model Serial No.

Nitrification Field: No. Fields Square Feet 1035 Linear Feet 345

No. Lines 6 Trench Width 36" Max Trench Bottom Depth 30" Gravel Depth

☑ ~~New System~~ Exist ☐ Repair ☐ Expansion System Type: I II III IV V VI

System Description: Convent Gravity

Repair System Description: 50% Lay Pipe

Maintenance Agreement Required: ☐ Yes ☑ No

☑ House/Mod. Home ☐ Mobile Home ☐ Business ☐ Other

No. Bedrooms 3 No. Persons No. Employees

Water Supply: ☑ Individual ☐ Public ☐ Community

☐ Gravity ☐ Pressure ☐ Slab ☑ Crawl Space ☐ Basement w/plumbing ☐ Basement wo/plumbing

Comments:/Conditions:


Maintain all ~~Septic~~ Setbacks

INITIAL SITE SKETCH

Comments:/Conditions:

Maintain 25' Off Well

AS BUILT SKETCH

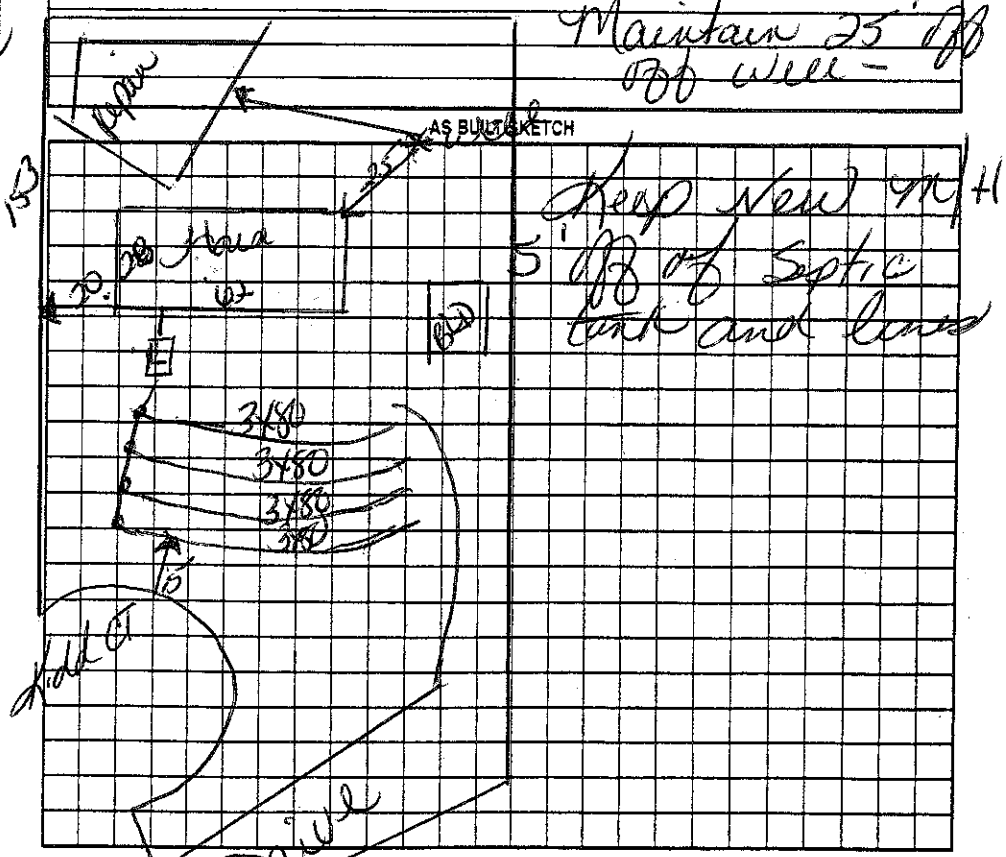

Permit can be suspended or revoked if any false information is supplied toward securing the permit/any unauthorized changes are made to the site/any unauthorized changes are made in the installation of the system. Improvement Permit with plat valid without expiration ☐ Improvement Permit with site plan valid for sixty months ☑ Authorization to Construct is valid for a period equal to that of Improvement Permit – not to exceed sixty months.

Signed: date Installed by:

Improvement Permit by: date Operation Permit by: date

Authorization to Construct by: date Existing System Inspection by: Kelly Cook date 7-25-08

HEALTH DEPT. COPY: WHITE OWNER COPY (FINAL): YELLOW OWNER COPY (INITIAL): PINK