IREDELL COUNTY HEALTH DEPARTMENT

STATESVILLE 704-878-5305 MOORESVILLE 704-664-5281

IMPROVEMENT PERMIT / CERTIFICATE OF COMPLETION / OPERATION PERMIT / EXISTING SYSTEM INSPECTION

PROPERTY DESCRIPTION NO. 20167 DATE 1-24-95 TAX MAP NO. 5B-3-A-49 Watershed: ☐ Yes ☑ No

OWNER OR CONTRACTOR Scott Beattie PHONE: Business Home

ADDRESS Rt 1 Box 259-A Troutman

LOCATION Hwy 70 E TR Bethesda Rd TR Reuben Dr TL Jeremy Ln 2nd lot Rt.

SUBDIVISION Beechwood BLOCK / SECTION II LOT 49 LOT AREA .503 acres SITE CLASS. PS DESIGN FLOW 360 L.T.A.R. .13

Septic Tank: 1000 Gallons; STB 821 Date 1-30-95

Pump Tank: Gallons; PT Date

Pump Make: Model Serial No.

Nitrification Field: No Fields 1 Square Feet 1200 Linear Feet 400

No Lines 4 Trench Width 36" Max Trench Bottom Depth 36" Gravel Depth 12"

☐ New System ☐ Repair System Type: I, ☑ II, III, IV, V, VI

System Description: Conv. Gravity

Repair System Description: Poras Block Panel

Maintenance Agreement Required: ☐ Yes ☑ No

☐ House/Mod. Home No. Bedrooms 3

☐ Mobile Home No. Bathrooms 2

☐ Business No. Employees

☐ Other


☐ Slab ☑ Crawl Space ☐ Basement w/plumbing ☐ Basement wo/plumbing

Water Supply: ☑ Individual ☐ Community ☐ Public

Comments:

Comments: System installed for 2 Bedroom Mtl. 270' of line installed instead of 400'. Home and well not located at time of inspect. Keep both required distances from Septic System.

INITIAL SITE SKETCH

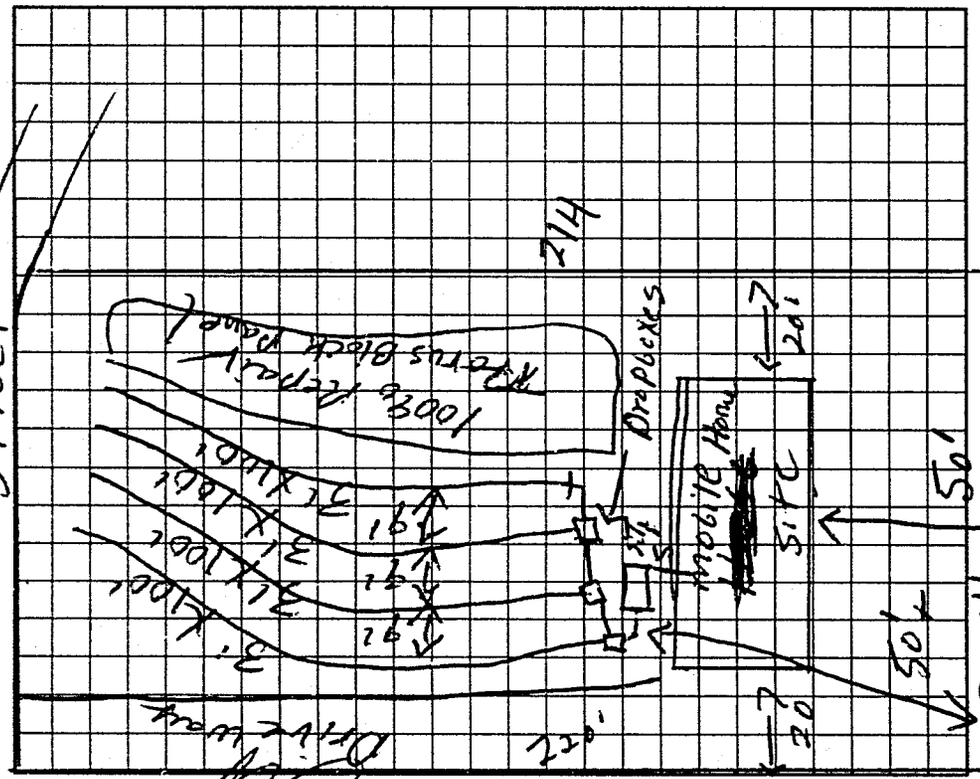

AS BUILT SKETCH

I understand that this permit can be suspended or revoked if any false information is supplied toward securing the permit/any unauthorized changes are made to the site/any unauthorized changes are made in the installation of the system. Improvement Permit is valid for 60 months from date of issuance.

Signed:

Improvement Permit by: J. C. Moore date 1-24-95

Existing System Inspection by: date

Installed by: G & M Enterprises

Certificate of Completion by: Michael G. Dennis date 3-16-95

Operation Permit by: date

HEALTH DEPT. COPY: WHITE INSPECTION COPY (FINAL): GREEN OWNER COPY (FINAL): YELLOW INSPECTION COPY (INITIAL): PINK OWNER COPY (INITIAL): GOLD