IREDELL COUNTY HEALTH DEPARTMENT

STATESVILLE 704-878-5305 (at) MOORESVILLE 704-664-5281

IMPROVEMENT PERMIT / AUTHORIZATION TO CONSTRUCT / OPERATION PERMIT / EXISTING SYSTEM INSPECTION

PERMIT # 158835 PIN # 4761366871 DATE 2-15-10

OWNER or APPLICANT Marty Tucker PHONE: Business Home: 704-902-0030

OWNER or APPLICANT ADDRESS 1044 Bethesda RD Statesville NC 28677

LOCATION / DIRECTIONS 145 → Exit 45-D Amity Hill (D) Oswalt Amity (D) Bethesda on left at Power lines

SUBDIVISION BLOCK / SECTION LOT # 5 LOT AREA .84Ac DESIGN FLOW 240 L.T.A.R. .25

Septic Tank 1000 Gallons: STB 794 Date 11-2-09
Pump Tank Gallons: P T Date
Pump Make Model Serial #
Nitrification Field No. Fields No. Lines 4 Linear Feet 240
Trench Width 36" Trench Bottom Depth 36" Gravel Depth NA

☑ New System ☐ Repair ☐ Expansion System Type I II III IV V VI
System Description: 2510 Gravelly
Repair System Description: 2510 Gravelly / Pump
Maintenance Agreement Required ☐ YES ☑ NO
☑ GRAVITY ☐ PRESSURE


☑ Residence No. Bedrooms 2
☐ Business No. Persons
☐ Other No. Employees
☐ Slab ☐ Crawl Space
☐ Basement w/plumbing ☐ Basement w/o plumbing

Water Supply: ☐ Private ☑ Public ☐ Community


Comments / Conditions
Install on Contour
Maintain all setbacks

Comments / Conditions
w/ no drop boxes

INITIAL SITE SKETCH

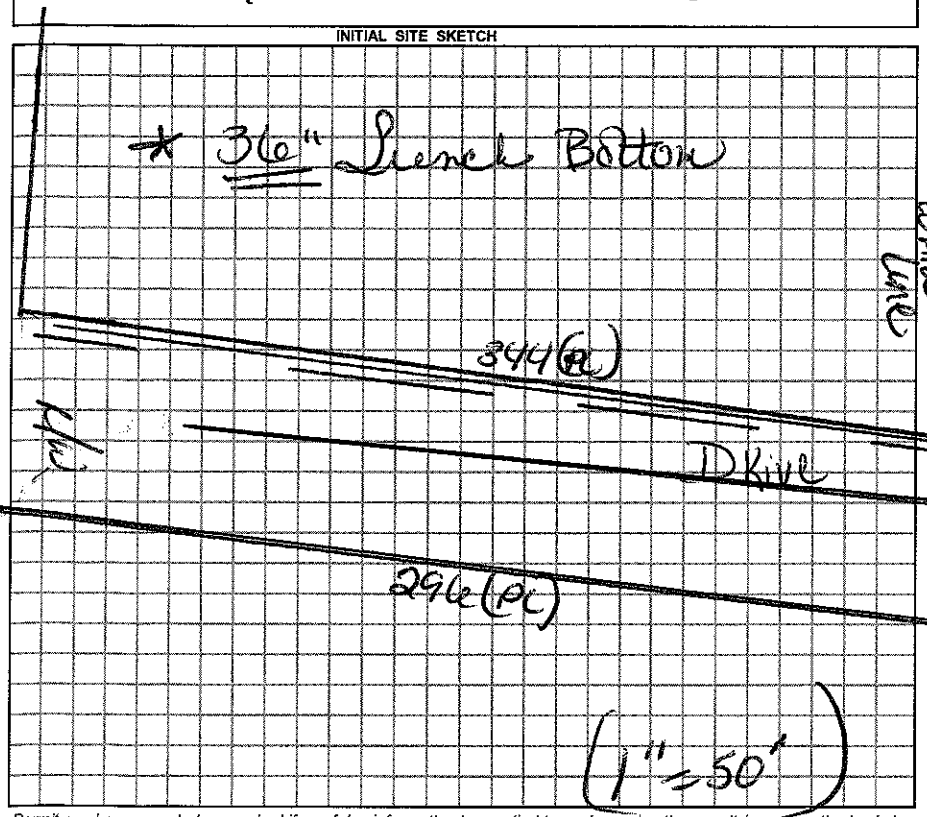

AS BUILT SKETCH

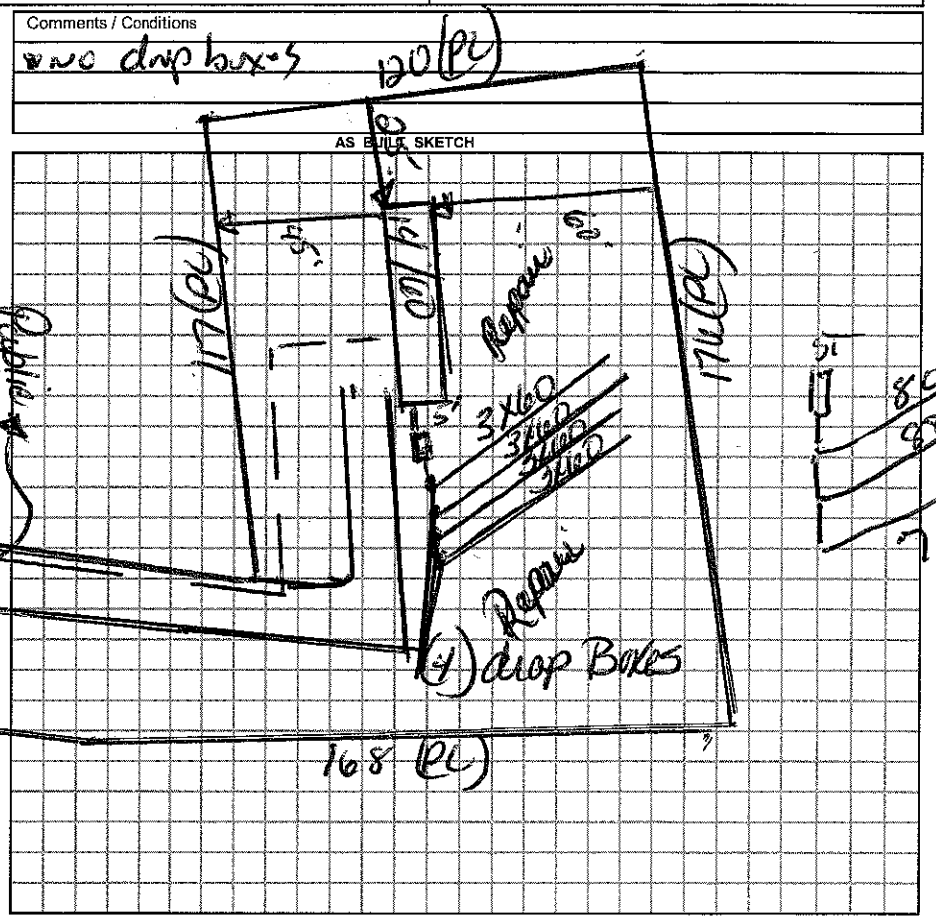

Permit can be suspended or revoked if any false information is supplied toward securing the permit / any unauthorized changes are made to the site / any unauthorized changes are made in the installation of the system.

☐ IMPROVEMENT PERMIT w / plat valid without expiration. ☑ IMPROVEMENT PERMIT w / site plan valid for 60 mos. ☑ AUTHORIZATION TO CONSTRUCT valid for period equal to IMPROVEMENT PERMIT-not to exceed 60 mo.

Owner / Applicant Signature: Melvin R. Tucker Date 4-6-2010

Improvement Permit by: Doug Cook Date 2-15-10

Authorization to Construct by: Doug Cook Date 2-15-10

YOU SHOULD CONTACT A LOCATOR SERVICE PRIOR TO ANY EXCAVATION.

Installed by: Marty Tucker

Operation Permit by: Jim Hoyle, R.S. Date: 7 April 10

Existing System Inspected by: Date:

WHITE COPY Environmental Health YELLOW COPY (Final) Owner / Applicant PINK COPY (Initial) Owner / Applicant