IREDELL COUNTY HEALTH DEPARTMENT

STATESVILLE 704-878-5305 (ad) MOORESVILLE 704-664-5281 (ad)

IMPROVEMENT PERMIT / AUTHORIZATION TO CONSTRUCT / OPERATION PERMIT / EXISTING SYSTEM INSPECTION

PERMIT # 15023 PIN # 4761-36-~~8620~~ 8587 DATE 1-5-09

OWNER or APPLICANT Mark Tucker PHONE: Business Home:

OWNER or APPLICANT ADDRESS 424 Bell Farm Rd

LOCATION / DIRECTIONS Oswalt Amity (T) Bethesda (TL) Bethesda Farms

SUBDIVISION Bethesda Farms BLOCK / SECTION LOT # 1 LOT AREA .45 DESIGN FLOW 360 L.T.A.R. .3

Septic Tank 1000 Gallons: STB 744 Date 3-11-09

Pump Tank Gallons: P T Date

Pump Make Model Serial #

Nitrification Field No Fields No Lines 4 Linear Feet 300

Trench Width 36" Max. Trench Bottom Depth 36" Gravel Depth NA

☑ New System ☐ Repair ☐ Expansion System Type I II III IV V VI

System Description: 25% Graute

Repair System Description: 25% reduction

Maintenance Agreement Required ☐ YES ☐ NO

☐ GRAVITY ☐ PRESSURE

☑ Residence No. Bedrooms

☐ Business No. Persons

☐ Other No. Employees

☐ Slab ☐ Crawl Space

☐ Basement w/plumbing ☐ Basement w/o plumbing

Water Supply: ☐ Private ☐ Public ☑ Community


Comments / Conditions

Bethesda Farms Rd

Comments / Conditions

Install on Contour
Maintain all setbacks

INITIAL SITE SKETCH

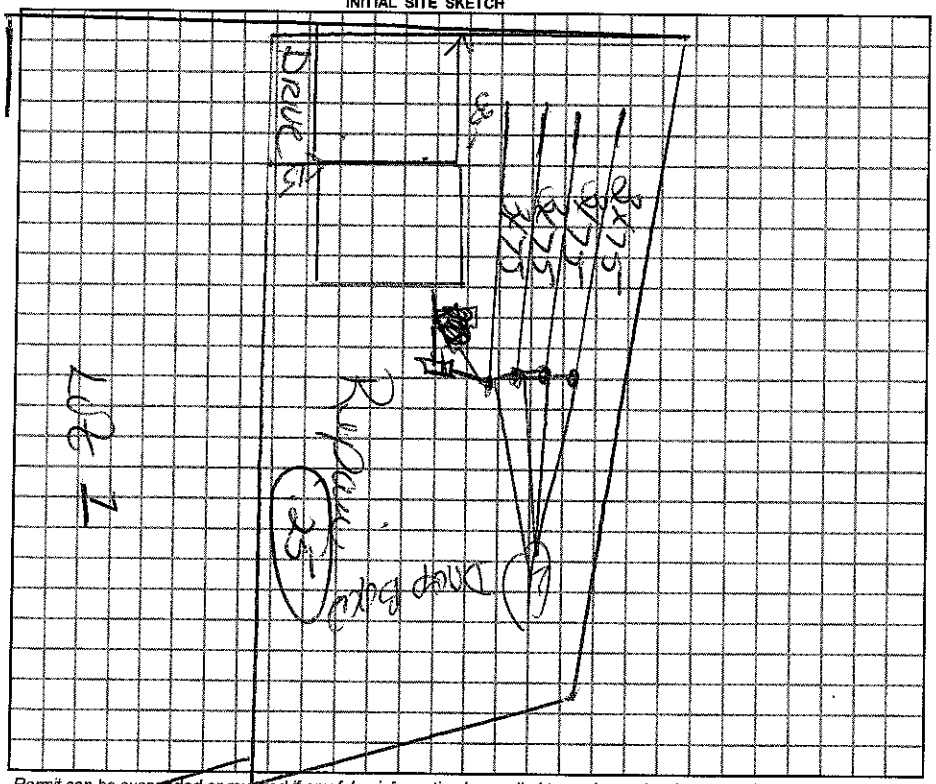

AS BUILT SKETCH

Was Raised in Trenches (6-11-09 Dug from)
Rock Ledge - Tile
Septic Marker

Permit can be suspended or revoked if any false information is supplied toward securing the permit / any unauthorized changes are made to the site / any unauthorized changes are made in the installation of the system.

☐ IMPROVEMENT PERMIT w / plat valid without expiration. ☐ IMPROVEMENT PERMIT w / site plan valid for 60 mos. ☑ AUTHORIZATION TO CONSTRUCT valid for period equal to IMPROVEMENT PERMIT-not to exceed 60 mo.

Owner / Applicant Signature: Mark Tucker Date 1-5-09

Improvement Permit by: Rusty Cox Date 1-5-09

Authorization to Construct by: Rusty Cox Date 1-5-09

YOU SHOULD CONTACT A LOCATOR SERVICE PRIOR TO ANY EXCAVATION.

Installed by: Mark Tucker

Operation Permit by: Rusty Cox Date: 6-15-09

Existing System Inspected by: Date:

WHITE COPY Environmental Health YELLOW COPY (Final) Owner / Applicant PINK COPY (Initial) Owner / Applicant