IREDELL COUNTY HEALTH DEPARTMENT

STATESVILLE 704-878-5305 MOORESVILLE 704-664-5281

IMPROVEMENT PERMIT / CERTIFICATE OF COMPLETION / OPERATION PERMIT / EXISTING SYSTEM INSPECTION

PROPERTY DESCRIPTION NO. 69706 DATE 10-10-97 TAX MAP NO. 4761367580 Watershed: ☐ Yes ☐ No

OWNER OR CONTRACTOR Jody Greer PHONE: Business Home 704 873 8716

ADDRESS 176 Village Dr. Statesville N.C.

LOCATION 70E ~~before~~ TR Bethesda pt before trinity oswalt old rd.

SUBDIVISION BLOCK / SECTION LOT LOT AREA 2.5 acres SITE CLASS. PS DESIGN FLOW 360 L.T.A.R. 133

Septic Tank: 1000 Gallons; STB 1012 Date 10-6-97

Pump Tank: Gallons; PT Date

Pump Make: Model Serial No.

Nitrification Field: No Fields 1 Square Feet 1080 Linear Feet 360

No Lines 4 Trench Width 36" Max Trench Bottom Depth 36" Gravel Depth 12"

☑ New System ☐ Repair System Type: I, II, III, IV, V, VI

System Description: conv. Gravity

Repair System Description: " "

Maintenance Agreement Required: ☐ Yes ☑ No

☐ House/Mod. Home No. Bedrooms 3

☑ Mobile Home No. Bathrooms 2

☐ Business No. Employees

☐ Other


☐ Slab ☑ Crawl Space ☐ Basement w/plumbing ☐ Basement wo/plumbing

Water Supply: ☑ Individual ☐ Community ☐ Public


Comments:

Comments:

INITIAL SITE SKETCH

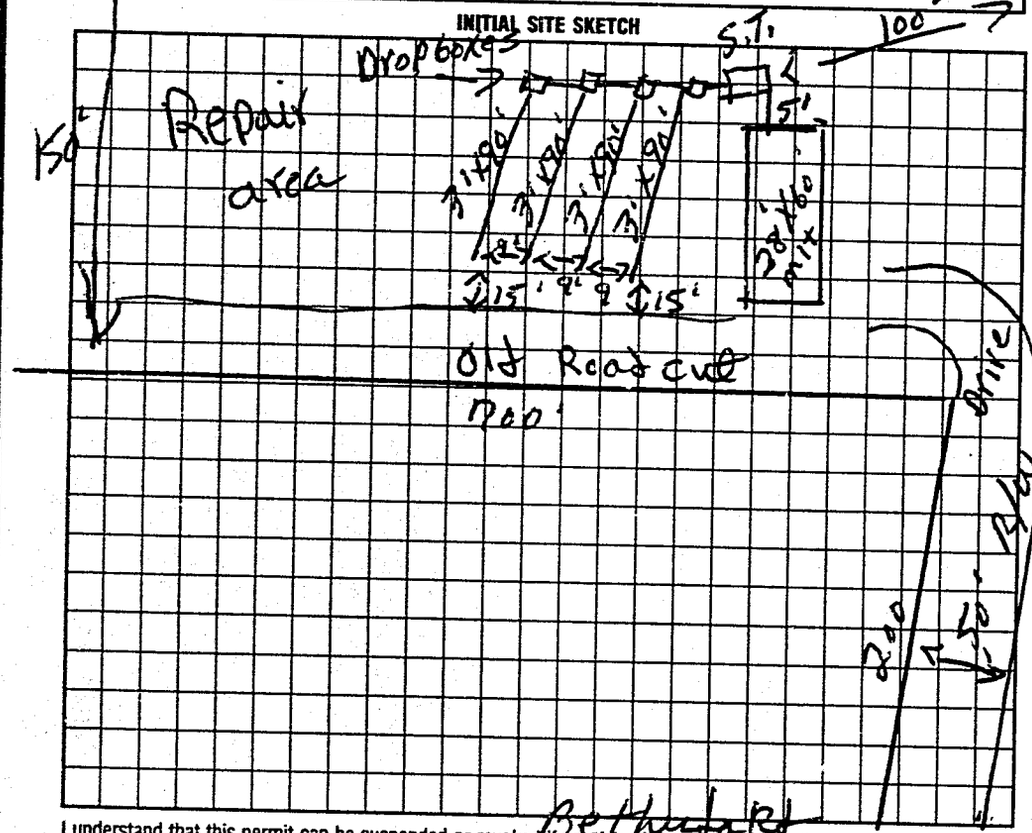

AS BUILT SKETCH

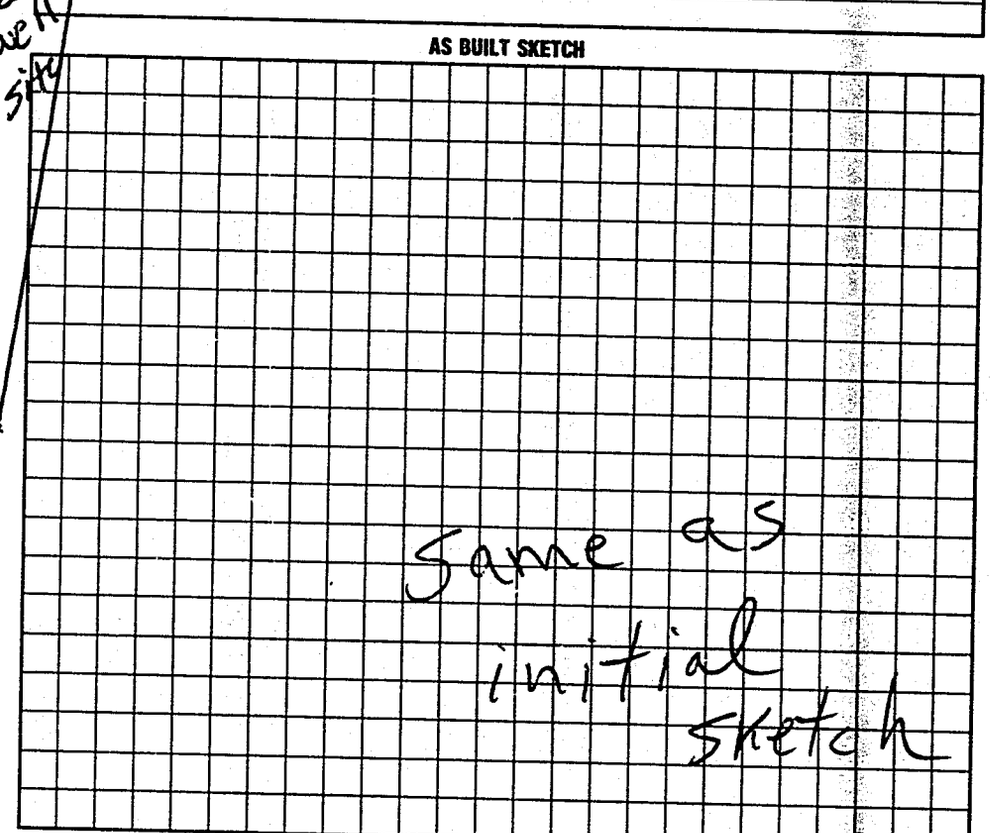

I understand that this permit can be suspended or revoked if any false information is supplied toward securing the permit/any unauthorized changes are made to the site/any unauthorized changes are made in the installation of the system. Improvement Permit is valid for 60 months from date of issuance.

Signed: X Jody Greer

Improvement Permit by: P.C. Moore date 10-10-97

Authorization to Existing System Inspection by: P.C. Moore date 10-10-97

to cont.

Installed by: Stuart Jordan

Certificate of Completion by: date

Operation Permit by: P.C. Moore date 1-30-98

HEALTH DEPT. COPY: WHITE INSPECTION COPY (FINAL): GREEN OWNER COPY (FINAL): YELLOW INSPECTION COPY (INITIAL): PINK OWNER COPY (INITIAL): GOLD

Authorization to cont EXPIRES 60 mos from issue