1:30

IREDELL COUNTY HEALTH DEPARTMENT - *ENVIRONMENTAL HEALTH* ☐ STATESVILLE OFFICE 704-878-5305 ☐ MOORESVILLE OFFICE 704-664-5281

IMPROVEMENT PERMIT / AUTHORIZATION TO CONSTRUCT / OPERATION PERMIT / EXISTING SYSTEM INSPECTION

PERMIT # Repair PIN # 4761-36-9840 DATE 1 March 11

OWNER James Culbertson APPLICANT: PHONE: Home/Cell # [redacted] ~~Business #~~ (704) 508-1046

SITE ADDRESS 1056 Bethesda Rd. Statesville OWNER / APPLICANT ADDRESS

SITE DIRECTIONS Hwy 70E TR Bethesda - 5mi on Rt.

SUBDIVISION BLOCK / SECTION LOT # LOT AREA 2.17ac. DESIGN FLOW 240gpd L.T.A.R. .03/ft²

Septic Tank Exist. Gallons: STB Date
Pump Tank Gallons: P T Date
Pump Make Model Serial #
No. Nitrification Fields: 1 No. Lines 4 Linear Feet 200
Trench Width 36" Max. Trench Bottom Depth 36" Gravel Depth NA


☐ New System ☑ Repair ☐ Expansion System Type I II (III) IV V VI
System Description:
Repair System Description: 25% Reduction
Maintenance Agreement Required ☐ YES ☑ NO
☑ GRAVITY ☐ PRESSURE

☑ Residence No. Bedrooms 2
☐ Business No. Persons
☐ Other No. Employees
☐ Slab ☑ Crawl Space
☐ Basement w/plumbing ☐ Basement w/o plumbing


Water Supply
☑ Private
☐ Public
☐ Community

Comments / Conditions * Replace tee with Filter Tee.

INITIAL SITE SKETCH

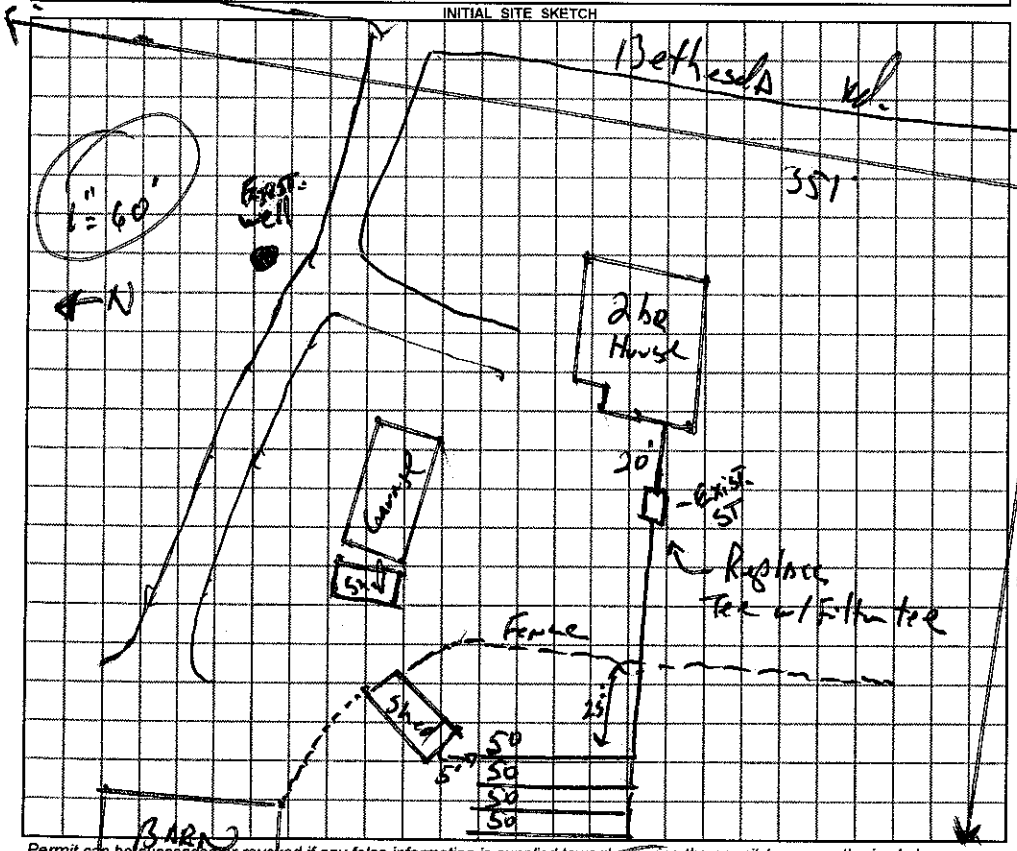

AS BUILT SKETCH

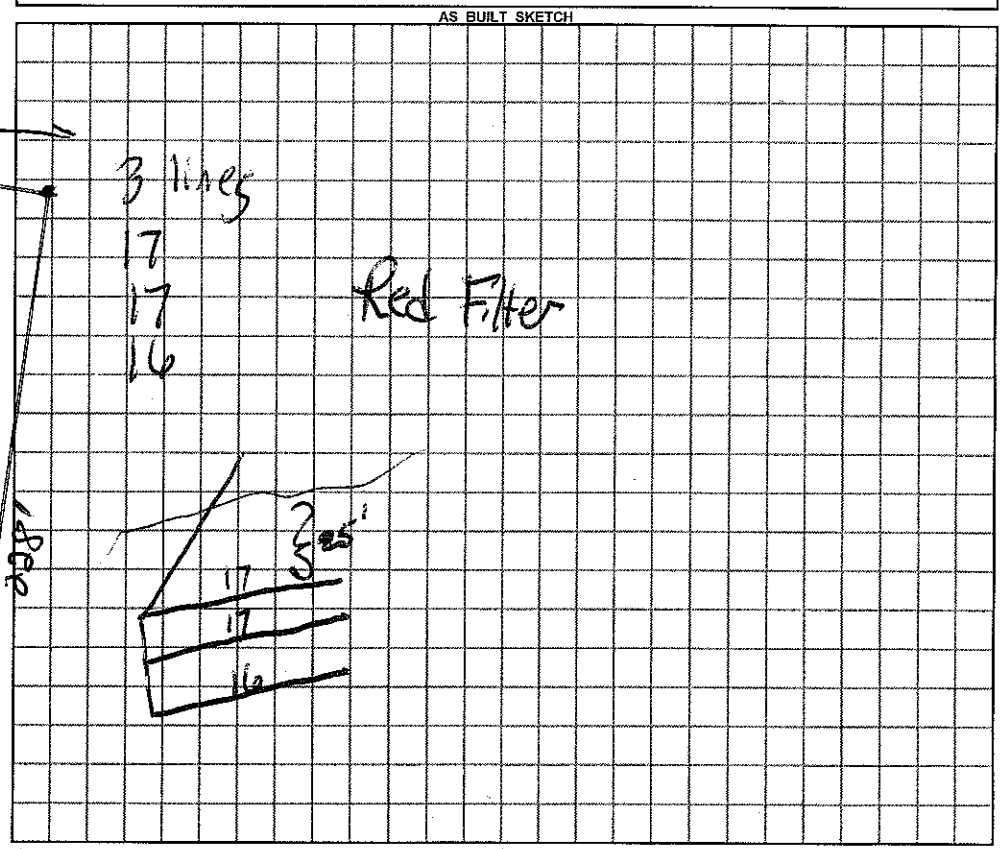

Permit can be suspended or revoked if any false information is supplied toward securing the permit / any unauthorized changes are made to the site / any unauthorized changes are made in the installation of the system.

☐ *IMPROVEMENT PERMIT* with plat valid without expiration. ☐ *IMPROVEMENT PERMIT* with plat valid ~~without expiration~~ 60 mos ☑ *AUTHORIZATION TO CONSTRUCT* valid for period equal to IMPROVEMENT PERMIT--not to exceed 60 mo.

Owner / Applicant Signature: Brenda Culbertson Date 3/11/11 Installed by: Rowan Septic

IMPROVEMENT PERMIT by: REHS Date 1 March 11 OPERATION PERMIT by: REHS Date 3-17-11

AUTHORIZATION TO CONSTRUCT by: REHS Date 1 March 11 Existing System Inspected by: REHS Date

YOU SHOULD CONTACT A LOCATOR SERVICE PRIOR TO ANY EXCAVATION

White Copy – Environmental Health YELLOW COPY (Final) Owner / Applicant PINK COPY (Initial) Owner / Applicant