5B-2-A-7

IREDELL COUNTY HEALTH DEPARTMENT

STATESVILLE 704-878-5305 MOORESVILLE 704-664-5281

IMPROVEMENT PERMIT / CERTIFICATE OF COMPLETION / OPERATION PERMIT / EXISTING SYSTEM INSPECTION

PROPERTY DESCRIPTION NO 17685 DATE 1-13-94 TAX MAP NO 5B-A-A-4 Watershed ☐ Yes ☐ No

OWNER OR CONTRACTOR Terry Hayes PHONE: Business _____ Home 663-1995

ADDRESS Rt 5 Box 385 Mooresville

LOCATION 70 E TR Statesville Before Int. TR Fieldcrest 1/8 mi on Rt

SUBDIVISION N.R.S. TANK/BLOCK/SECTION A LOT 7 LOT AREA 1.310 acres SITE CLASS PS DESIGN FLOW 360 LTAR .35

Septic Tank 1000 Gallons SIR 35' Date 11-27-93
Pump Tank _____ Gallons PT _____ Date _____
Pump Make _____ Model _____ Serial No _____
Application Field No Fields 1 Square Feet 1035 Linear Feet 345
No Lines 3 Trench Width 36" Min Trench Bottom Depth 36" Gravel Depth 12" Slab Crawl Space ☐ Basement w/plumbing ☐ Basement w/o plumbing

☐ New System ☐ Repair System Type (I) (C) (E) (A) (M)
System Description: _____
Repair System Description: _____
Maintenance Agreement Required ☐ Yes ☐ No


☐ House/Mod. Home No Bedrooms 3
☐ Mobile Home No. Bathrooms 2
☐ Business No. Employees _____
☐ Other _____

Water Supply: ☐ Individual ☐ Community ☐ Public

Comments _____

Comments well & mh were not located at time of this inspection locate at proper distances from S.T. system

INITIAL SITE SKETCH

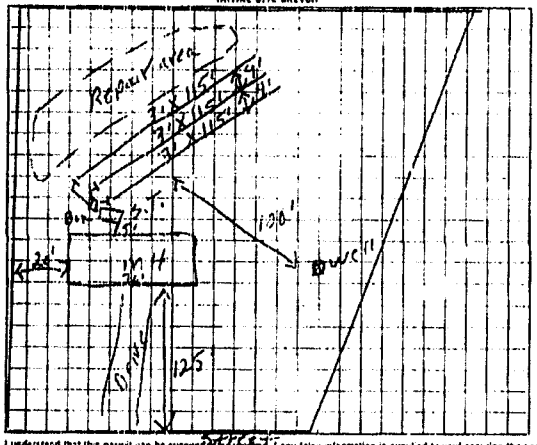

AS BUILT SKETCH

as shown on initial sketch

same as initial sketch

I understand that this permit can be suspended/revoked if any false information is supplied toward securing the permit/any unauthorized changes are made to the site/any unauthorized changes are made in the installation of the system. Improvement Permit is valid for 60 months from date of issuance

Signed X Terry Hayes

Improvement Permit by P. C. Moore date 1-13-94

Existing System Inspection by _____ date _____

Installed by Donald Fahey

Certificate of Completion by P. C. Moore date 1-25-94

Operation Permit by _____ date _____

HEALTH DEPT COPY (WHITE) PERMITTEE COPY (FINAL) GREEN OWNER COPY (FINAL) YELLOW INSPECTION COPY (INITIAL) PINK OWNER COPY (INITIAL) GOLD

JAN. 20, 1989 2:55