IREDELL COUNTY HEALTH DEPARTMENT

STATESVILLE 704-878-5305 MOORESVILLE 704-664-5281

IMPROVEMENT PERMIT / AUTHORIZATION TO CONSTRUCT / OPERATION PERMIT / EXISTING SYSTEM INSPECTION

PERMIT# 87693 PIN# 4761375477 DATE 2-09-00

OWNER OR CONTRACTOR Billy Baxter Sr. PHONE: Business Home 528 3544

ADDRESS 1016 Bethesta Rd Statesville, N.C.

LOCATION 70E TR Bethesta TR Field Crest 2nd Drive Rt

SUBDIVISION Woodhaven Est BLOCK / SECTION LOT 6 LOT AREA 1.22 acres SITE CLASS PS DESIGN FLOW 240 L.T.A.R. .135

Septic Tank: 1000 Gallons; STB 1012 Date 11-7-99
Pump Tank: Gallons; PT Date
Pump Make: Model Serial No.
Nitrification Field: No Fields 1 Square Feet 690 Linear Feet 630
No Lines 2 Trench Width 36" Max Trench Bottom Depth 36" Gravel Depth 12"

☒ New System ☐ Repair System Type: I, ☒ III, IV, V, VI
System Description: Conv. Gravity
Repair System Description: " "
Maintenance Agreement Required: ☐ Yes ☒ No

☐ House/Mod. Home ☒ Mobile Home ☐ Business ☐ Other
No. Bedrooms 2 No. Bathrooms 2 No. Employees


Water Supply: ☒ Individual ☐ Public ☐ Community

☐ Slab ☒ Crawl Space ☐ Basement w/plumbing ☐ Basement wo/plumbing

Comments/Conditions:

Comments/Conditions

INITIAL SITE SKETCH

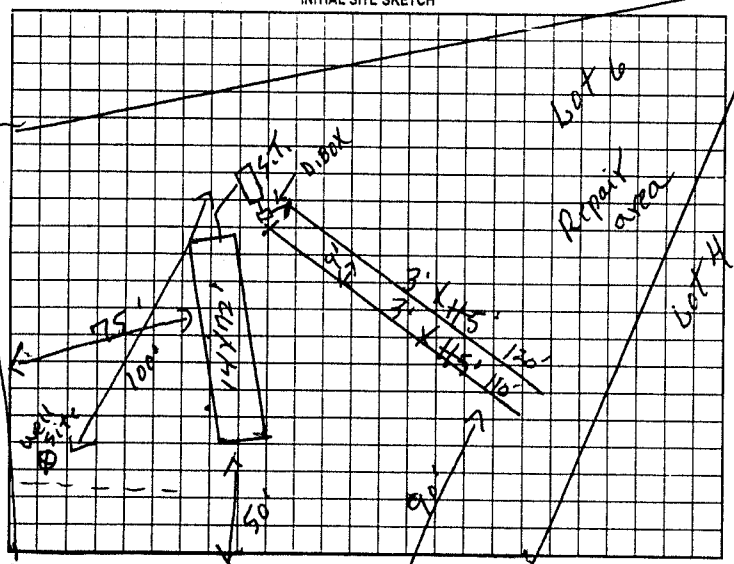

AS BUILT SKETCH

Permit can be suspended or revoked if any false information is supplied toward securing the permit/any unauthorized changes are made to the site/any unauthorized changes are made in the installation of the system. Improvement Permit with plat valid without expiration. Improvement Permit with site plan valid for sixty months. Authorization to Construct is valid for a period equal to that of Improvement Permit – not to exceed sixty months.

Signed: X Billy J. Baxter date

Improvement Permit by: P. C. Moore date 2-09-00

Authorization to Construct by: P. C. Moore date 2-09-00

Installed by: A/ Backhoe

Operation Permit by: C. Potter date March 2-2000

Existing System Inspection by: date

HEALTH DEPT. COPY: WHITE OWNER COPY (FINAL): YELLOW OWNER COPY (INITIAL): PINK