IREDELL COUNTY HEALTH DEPARTMENT

STATESVILLE 704-878-5305 MOORESVILLE 704-664-5281

IMPROVEMENT PERMIT / AUTHORIZATION TO CONSTRUCT / OPERATION PERMIT / EXISTING SYSTEM INSPECTION

PERMIT# 77090 PIN# 4761 37 6193 DATE 10-22-98

OWNER OR CONTRACTOR Earl Connell PHONE: Business Home 528 5906

ADDRESS 1070 Bethesda Rd

LOCATION 119, Fieldcrest 70 E TR Bethesda TR Fieldcrest 2nd lot on left

SUBDIVISION Wood Haven Est. BLOCK / SECTION LOT 10 LOT AREA 160' X 379 SITE CLASS. DESIGN FLOW 360 L.T.A.R. .3

Septic Tank: EX. Gallons: STB Date

Pump Tank: Gallons: PT Date

Pump Make: Model Serial No.

Nitrification Field: No Fields 1 Square Feet 402 Linear Feet 134

No Lines 2 Trench Width 36" Max Trench Bottom Depth 36" Gravel Depth 12"

☐ New System ☐ Repair System Type: I, (II), III, IV, V, VI

System Description: Expansion

Repair System Description: Conv. Gravity

Maintenance Agreement Required: ☐ Yes ☒ No

☐ House/Mod. Home ☑ Mobile Home ☐ Business ☐ Other

No. Bedrooms 3 No. Bathrooms 2 No. Employees

☐ Slab ☒ Crawl Space ☐ Basement w/plumbing ☐ Basement wo/plumbing


Water Supply: ☑ Individual ☐ Public ☐ Community

Comments:/Conditions: original system installed 2-21-92 Well next to door


System To Be Expanted as shown To bring up to 3 bedroom standards

Comments:/Conditions:

INITIAL SITE SKETCH

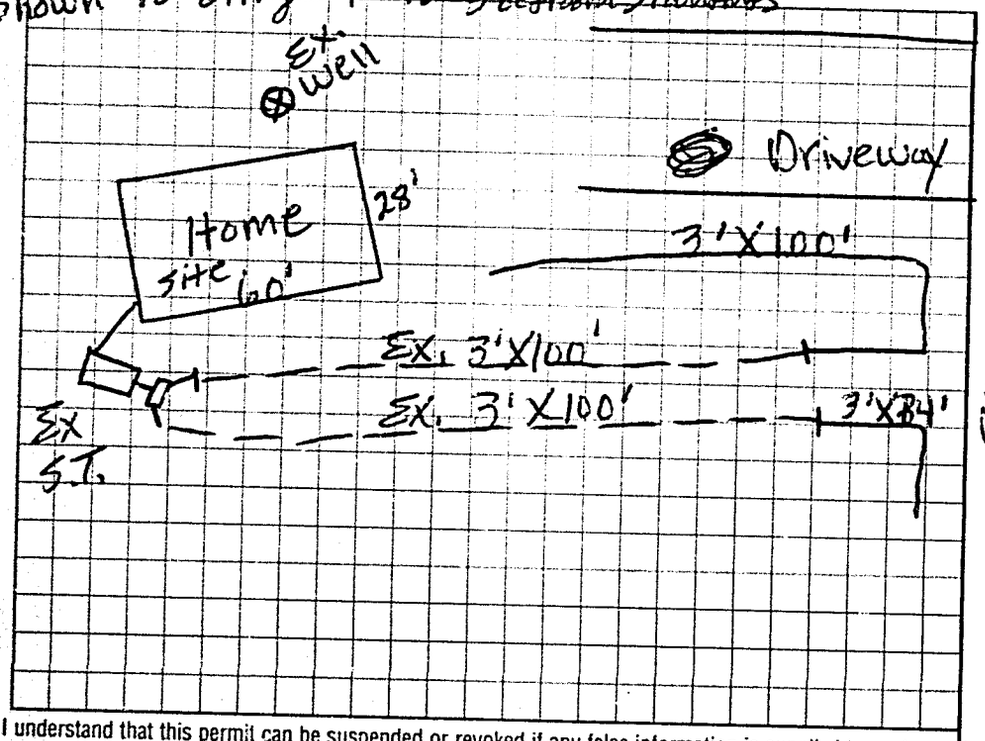

AS BUILT SKETCH

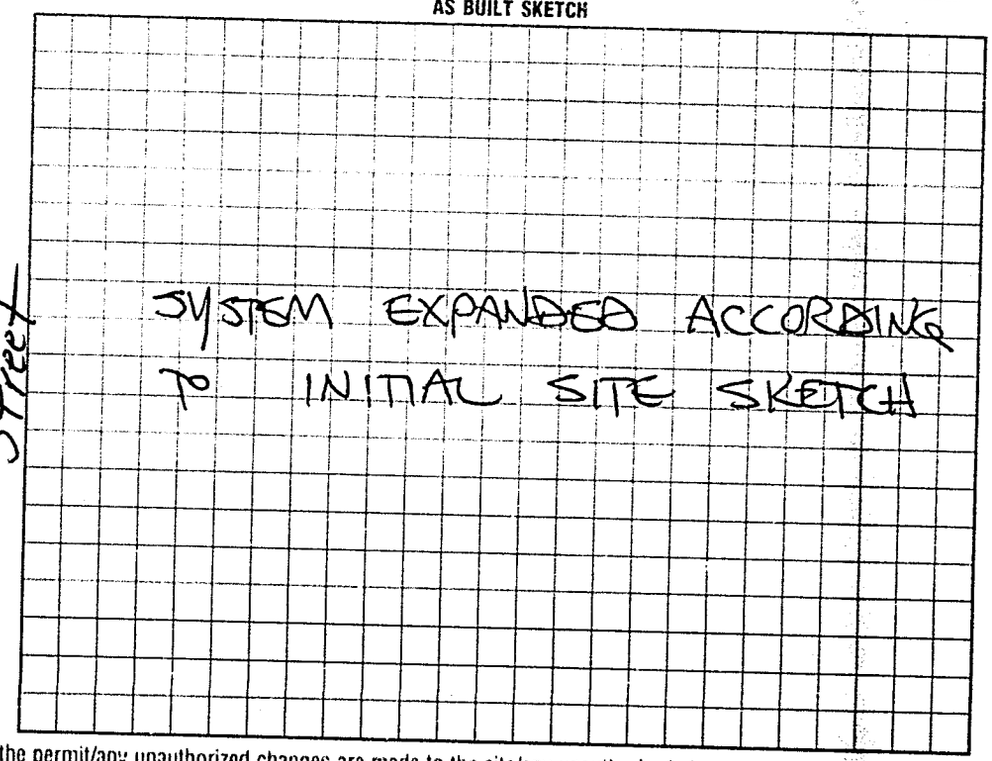

I understand that this permit can be suspended or revoked if any false information is supplied toward securing the permit/any unauthorized changes are made to the site/any unauthorized changes are made in the installation of the system. Improvement Permit with plat valid without expiration. Improvement Permit with site plan valid for sixty months. Authorization to Construct is valid for a period equal to that of Improvement Permit – not to exceed sixty months.

Signed: Mary Connell date 10-26-98 Installed by: BSC (BARRY SIGMON)

Improvement Permit by: L.C. Moore date 10-22-98 Operation Permit by: STEVE HEDRICK date 10-27-98

Authorization to Construct by: L.C. Moore date 10-22-98 Existing System Inspection by: date

HEALTH DEPT. COPY (WHITE) INSPECTION COPY (FINAL) GREEN OWNER COPY (FINAL) YELLOW INSPECTION COPY (INITIAL) PINK OWNER COPY (INITIAL) GOLD